


ABELL
SURVEYING & MAPPING
DELAVAN, WISCONSIN 53115
414-728-6737

JUL 9 1986

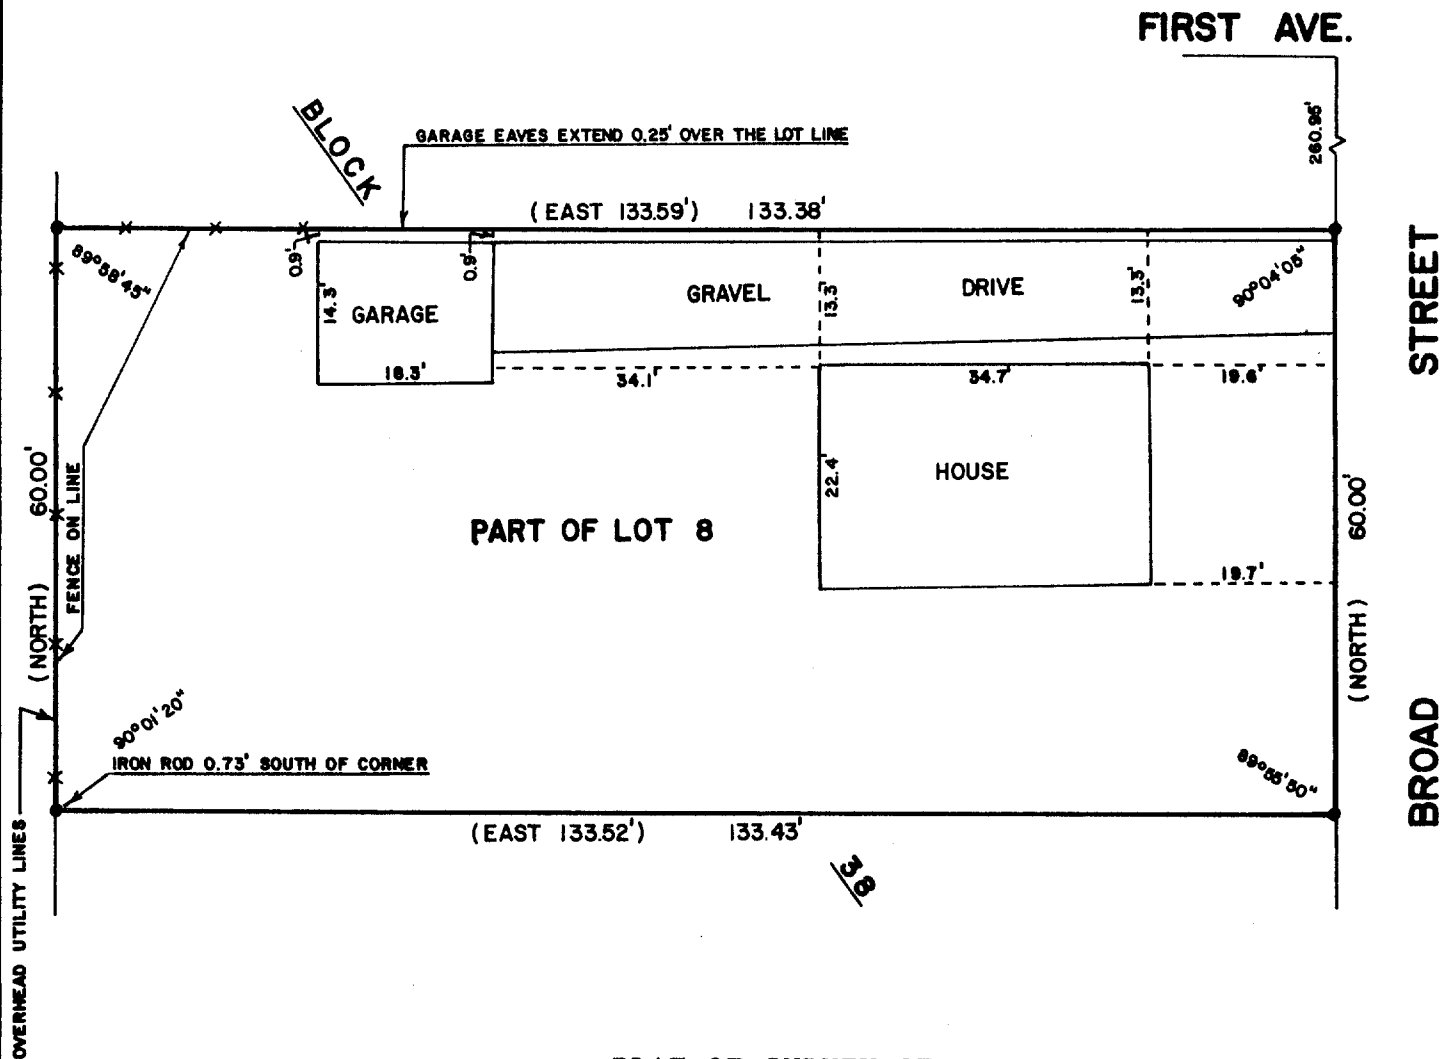

PLAT OF SURVEY OF

PART OF LOT 8, BLOCK 38, DAVIS ADDITION, CITY OF
ELKHORN, WALWORTH COUNTY, WISCONSIN AS DESCRIBED
IN VOLUME 358 OF RECORDS ON PAGE 463 AS DOCUMENT
NO. 123328, WALWORTH COUNTY, WISCONSIN.

ORDERED BY: THE RAULAND AGENCY
118 KENOSHA STREET
WALWORTH, WI 53184


NOTE: MR. TUBBS, AS CITY ENGINEER, RESURVEYED
ELKHORN AND FOUND OVERRUN AND UNDERRUN
IN THE BLOCKS AND RECORDED THE MEASUREMENTS
IN THE CITY ENGINEERING RECORDS.

I HEREBY CERTIFY THAT I HAVE SURVEYED THE
ABOVE DESCRIBED PROPERTY AND THAT THE ABOVE
MAP IS A TRUE REPRESENTATION THEREOF AND
SHOWS THE SIZE AND LOCATION OF THE PROPERTY,
ITS EXTERIOR BOUNDARIES, THE LOCATION OF ALL
PRINCIPAL BUILDINGS THEREON, BOUNDARY FENCES,
APPARENT EASEMENTS, ROADWAYS, AND VISIBLE
ENCROACHMENTS, IF ANY, TO THE BEST OF MY
KNOWLEDGE AND BELIEF.

THIS SURVEY IS MADE FOR THE USE OF THE
PRESENT OWNERS OF THE PROPERTY, AND ALSO
THOSE WHO PURCHASE, MORTGAGE, OR GUARANTEE
THE TITLE THERETO WITH ONE (1) YEAR FROM
DATE HEREOF.

David F. Abell
DAVID F. ABELL
WISCONSIN REGISTERED LAND SURVEYOR, S-1596

DATE *June 20, 1986* JOB NUMBER - 86014

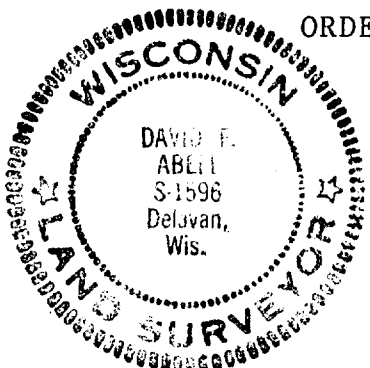

SCALE - 1"=20'

LEGEND

- - 1" IRON ROD FOUND
- () - RECORDED AS

YD-20

4-394-A