
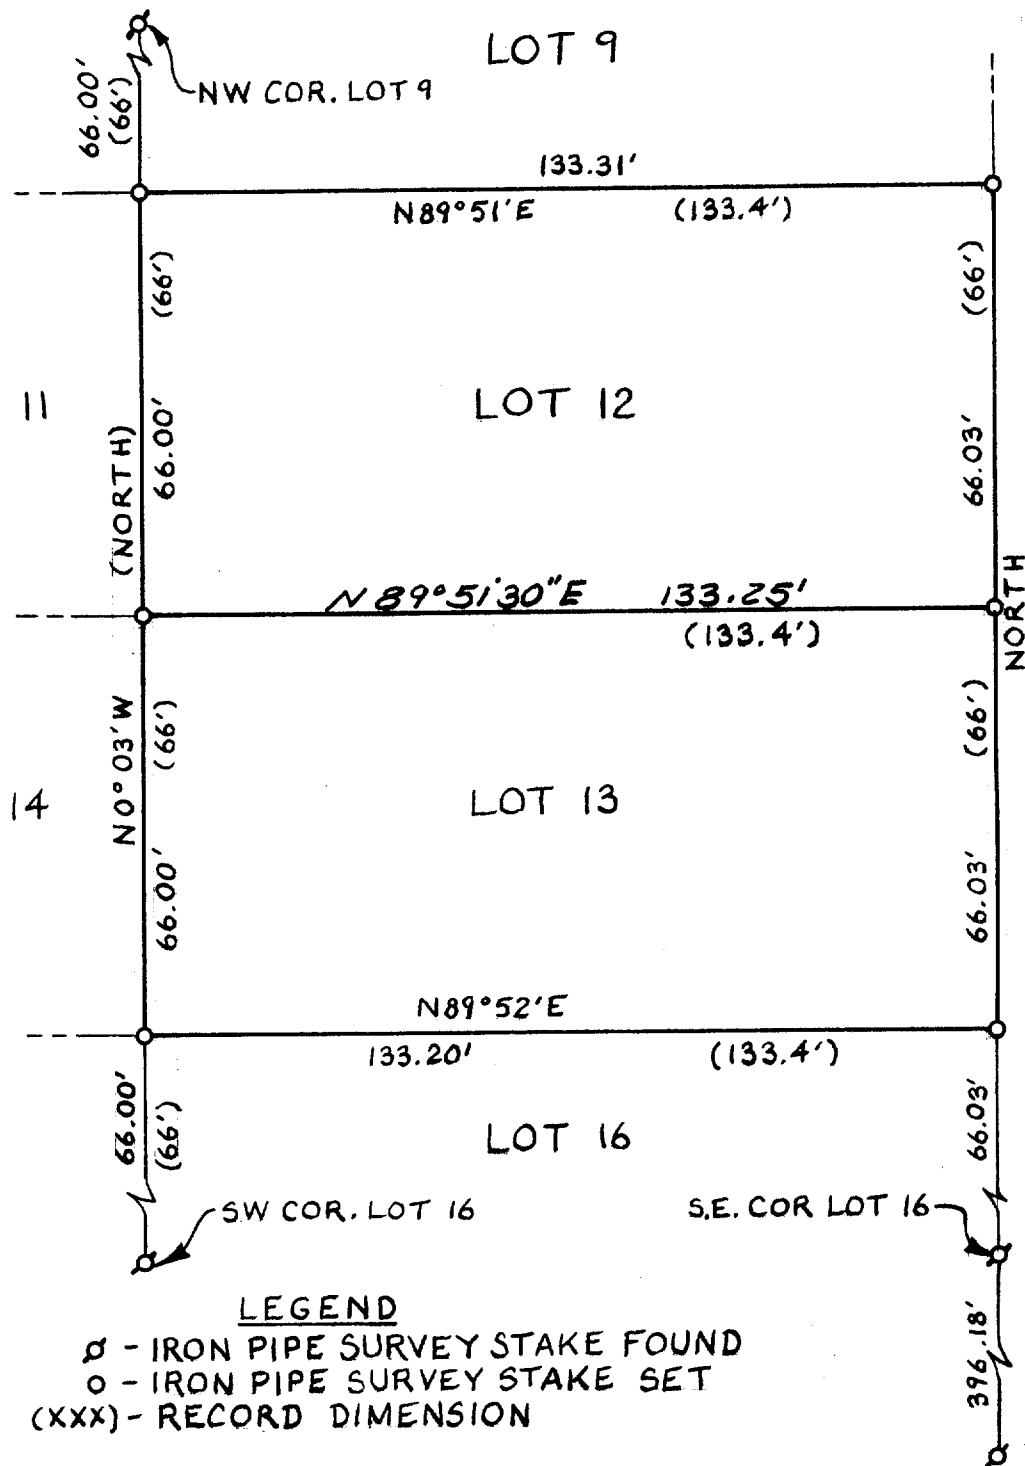


PLAT OF SURVEY OF LOTS 12 & 13 of
BLOCK 1 OF HOLTON HEIGHTS SUBDIVISION IN THE
CITY OF ELKHORN, WALWORTH COUNTY, WISCONSIN
FOR
THE ROBERT KENNEY ESTATE

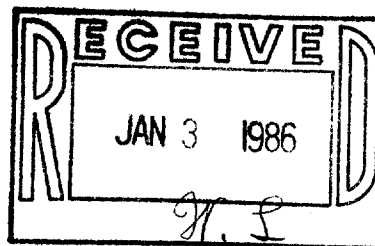

LEGEND
 x - IRON PIPE SURVEY STAKE FOUND
 o - IRON PIPE SURVEY STAKE SET
 (xxx) - RECORD DIMENSION


N
 MAP SCALE: 1" = 30'
 WEST LINE WISC. ST.
 ASSIGNED N 0° 00' E

I HEREBY CERTIFY THAT THE ABOVE DESCRIBED PROPERTY WAS SURVEYED
 UNDER MY DIRECTION AND THAT THIS PLAT IS A TRUE AND ACCURATE
 REPRESENTATION OF THE LOT LINES TO THE BEST OF MY KNOWLEDGE AND
 BELIEF.

Robert A. Farris
 Robert A. Farris, R.L.S.

Dated this 14th day of November, 1985

FARRIS, HANSEN & ASSOCIATES, INC.
 7 Ridgeway Ct.
 Elkhorn, WI 53121

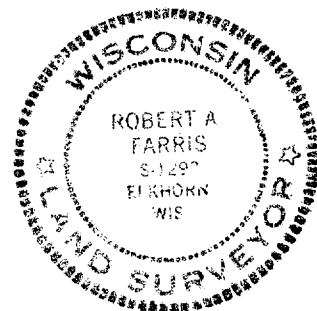

PROJECT # 2503 ✓✓
 4-395-F

YHT-00005