


PLAT OF SURVEY OF LOT 2 OF GREEN ACRES SUBDIVISION
CITY OF ELKHORN, WALWORTH CO., WIS.
FOR JONNIE SCHRANZ 9/0 WANSAN HOMES
LOCATED IN NW 1/4 SEC. 8, T. 2N., R. 17E.

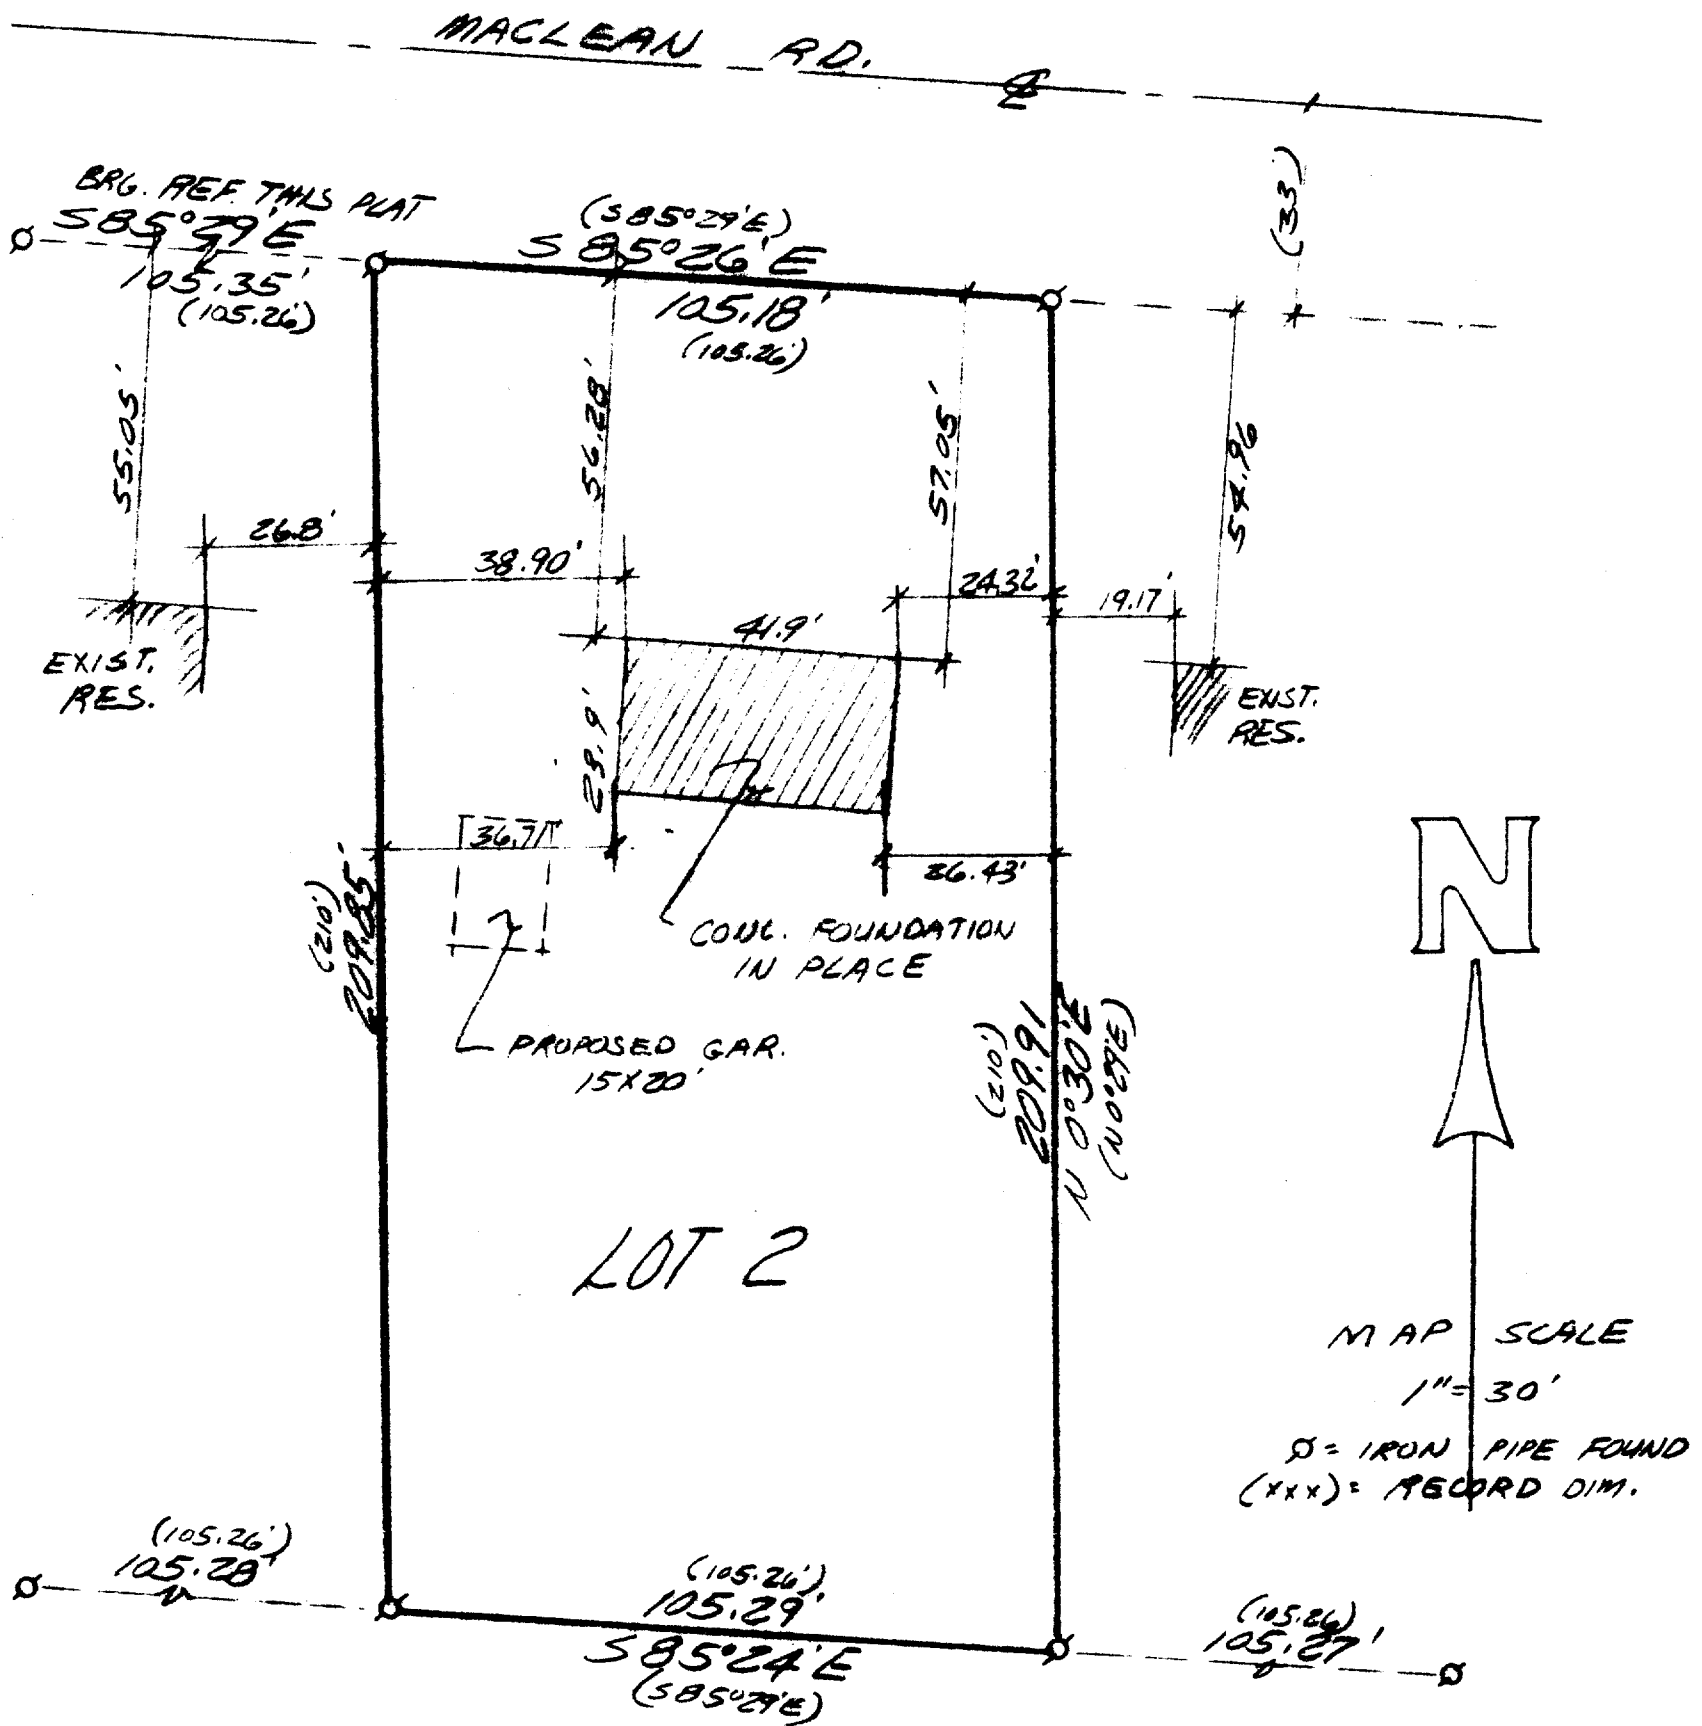



MAP SCALE
1" = 30'

Ø = IRON PIPE FOUND
(XXX) = RECORD DIM.

I HEREBY CERTIFY THIS MAP TO BE A TRUE AND ACCURATE REPRESENTATION
OF THE LOT LINES AND BUILDING LOCATION TO THE BEST OF MY
PROFESSIONAL KNOWLEDGE AND BELIEF

Robert A. Farris

DATED 12/23/85

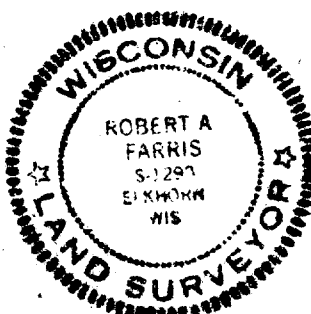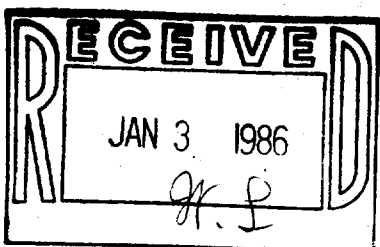

FARRIS, HANSEN & ASSOCIATES, INC.
715 W. Walworth St. P.O. Box 487
Elkhorn, WI 53121

PROJECT # 2501

4-396-FV

YGR-00009