


SCALE - 1" = 30'
O = IRON PIPE PLACED
X = IRON PIPE FOUND

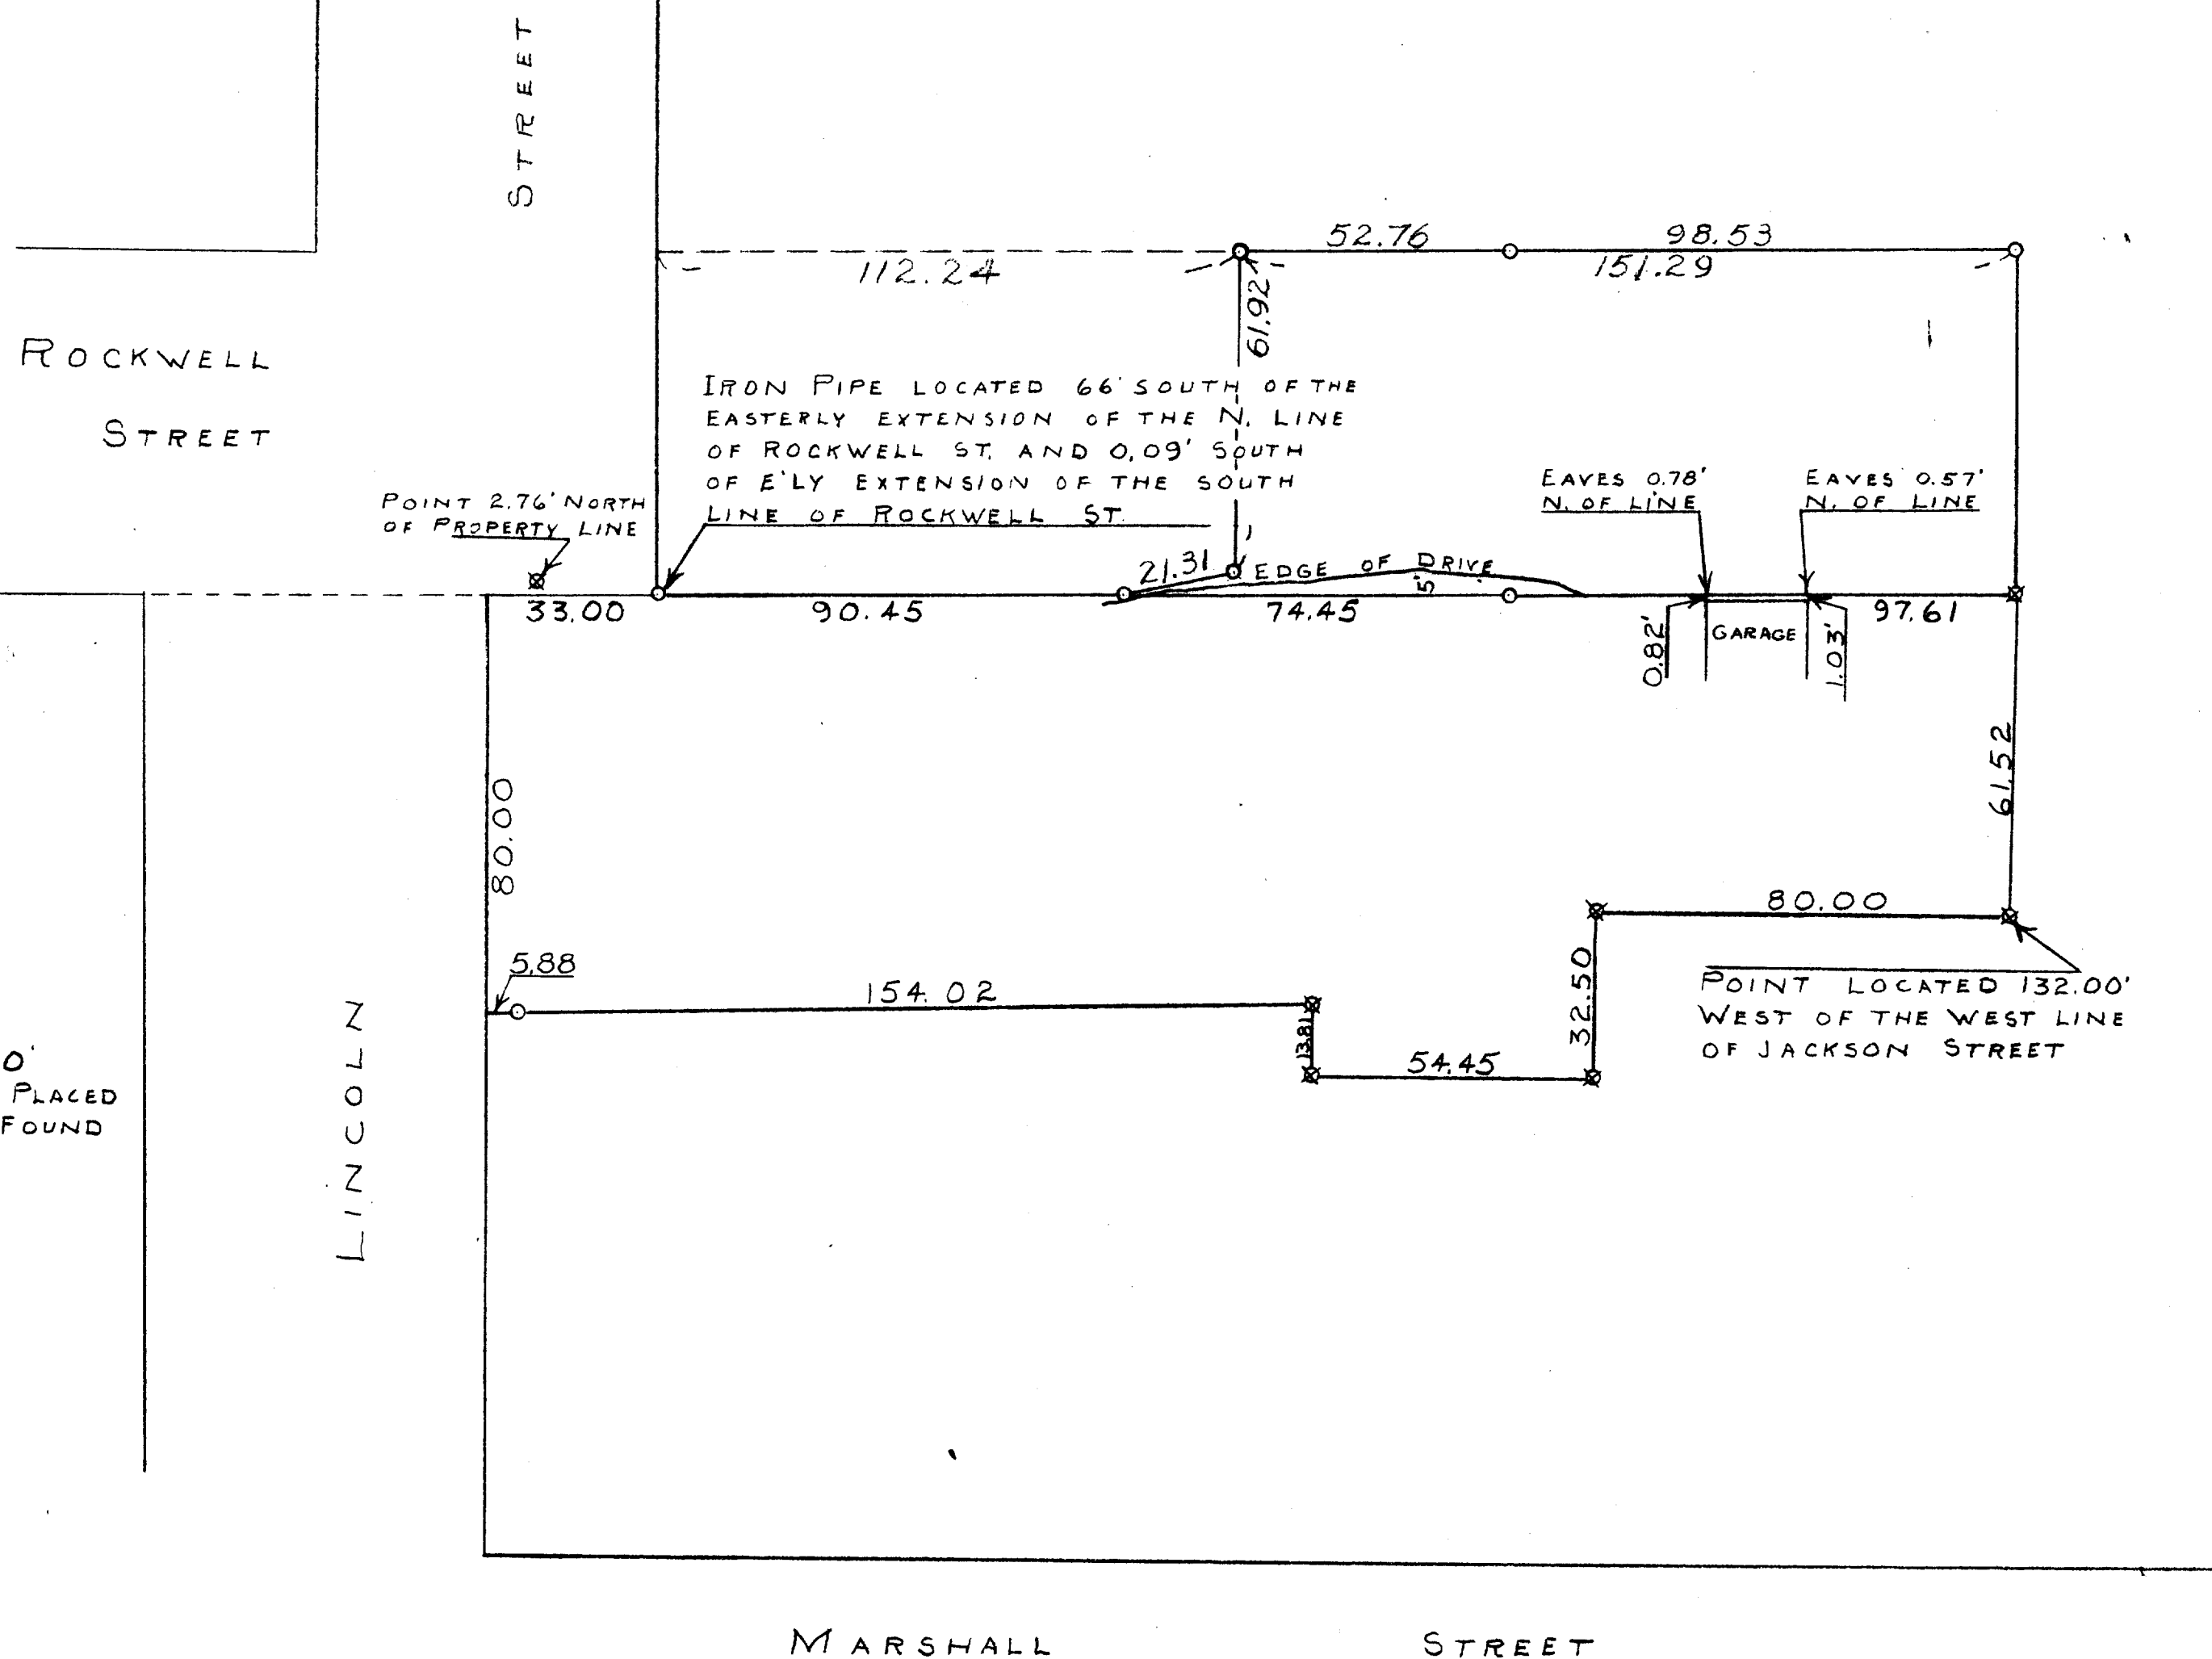

PLAT OF SURVEY OF PART OF BLOCK 1, ELDERKIN'S ADDITION TO THE VILLAGE (NOW CITY) OF ELKHORN, WALWORTH COUNTY, WISCONSIN
SEPT. 30, 1954
REVISED JULY 18, 1957
George T. Dunham
GEORGE T. DUNHAM, SURVEYOR
DELAVER, WISCONSIN