


COPY

ALBERT E. PENNEQUIN
LAND SURVEYOR
ELKHORN, WI TEL 723-3367

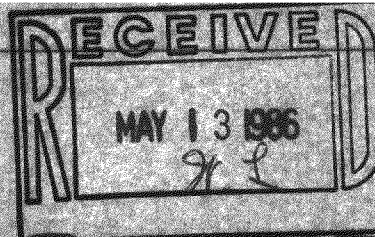



Map of Property of Mr. and Mrs Ralph PETERS

Lot 43 LANDMARK SUBDIVISION ADDITION #1 ELKHORN WISCONSIN SW 1/4 OF SW 1/4, SECT. 36, T3N R16E

RETRACEMENT OF BOUNDARY LINES

LEGEND

- Found Iron Pipe
- Set Monument, Bernitsen aluminum cap Model SCD-5, flat top, 1 7/8 diam. stamped as shown, set on 5/8 steel rebar 3' deep, set flush with ground.
- b.s. = below ground surface.
- () record measure

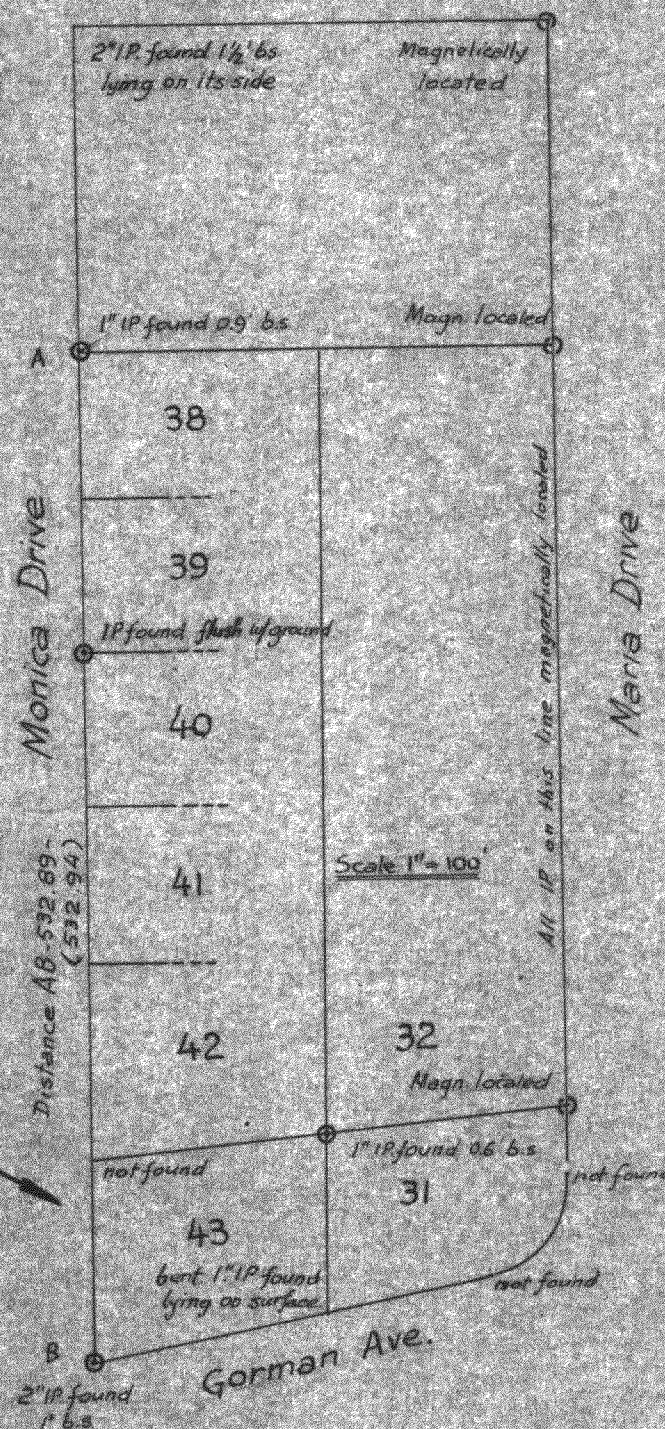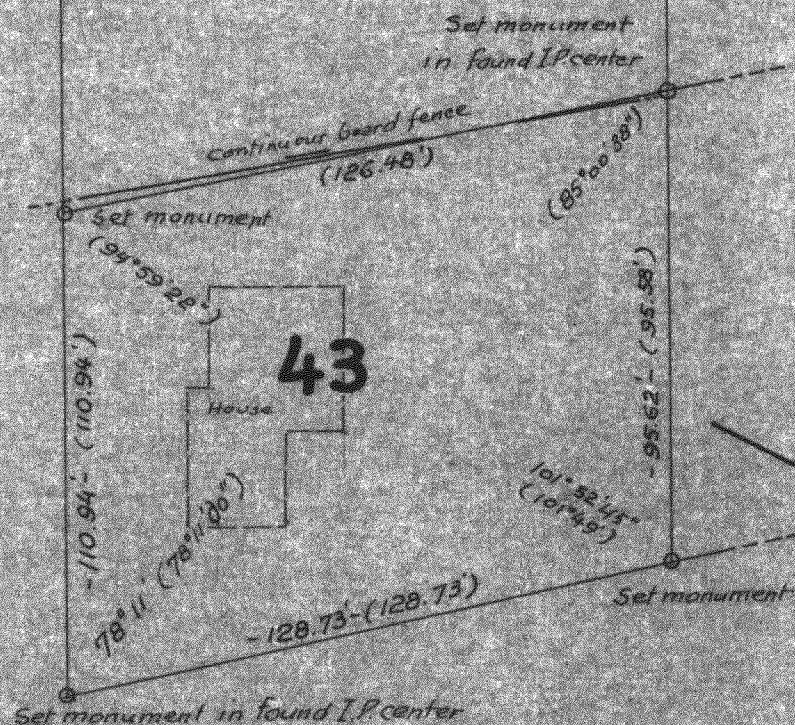

I certify that I have performed the necessary research and surveyed the land represented herein according to the available records, and that the monuments set or found are within the accepted standards of location tolerance as for this date. This survey valid for the present owner only.

Albert E. Pennequin
Albert E. PENNEQUIN RLS N° 1437
October 17, 1984

4-404✓