
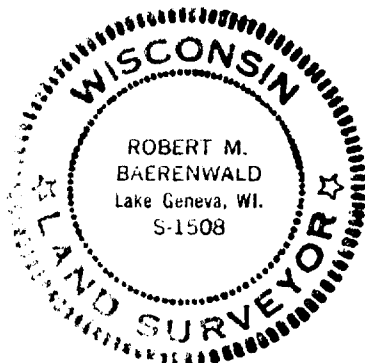


WALWORTH COUNTY
SURVEYING & MAPPING
LAKE GENEVA, WISCONSIN

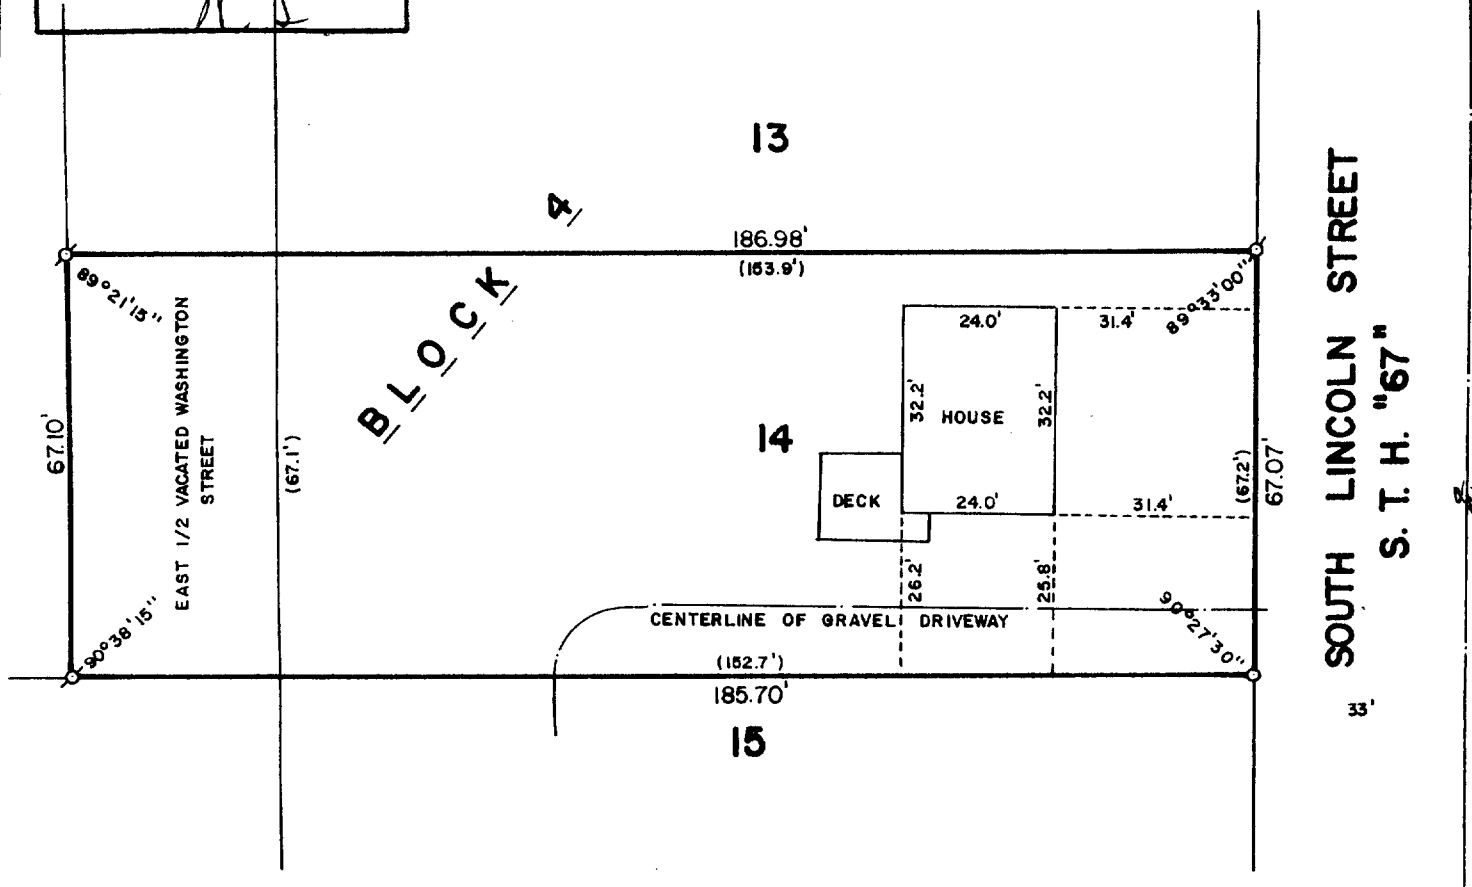

PLAT OF SURVEY OF

LOT 14, BLOCK 4 AND ALSO THE EAST 1/2
OF VACATED WASHINGTON STREET WHICH
ADJOINS SAID LOT 14, ALL LOCATED IN
PRESTON'S ADDITION, CITY OF ELKHORN,
WALWORTH COUNTY, WISCONSIN.

ORDERED BY: MIKROT REALTY
RT. 5, BOX 453
LAKE GENEVA, WISCONSIN 53147



SCALE: 1"=30'

- ⊙ - IRON PIPE FOUND
- - IRON ROD SET
- () - RECORDED AS

I, ROBERT M. BAERENWALD, DO HEREBY CERTIFY THAT I
HAVE SURVEYED THE PROPERTY HEREON DESCRIBED ACCORDING
TO THE OFFICIAL RECORDS AND THAT THE PLAT HEREON IS A
CORRECT REPRESENTATION OF THE PROPERTY LINES TO THE
BEST OF MY KNOWLEDGE AND BELIEF.

Robert M. Baerenwald
ROBERT M. BAERENWALD
WISCONSIN REGISTERED LAND SURVEYOR, S-1508

DATE June 20, 1986
JOB NO. 0604

YP-00029

4-409