


N



O

IRON PIPE

PARCEL # 5

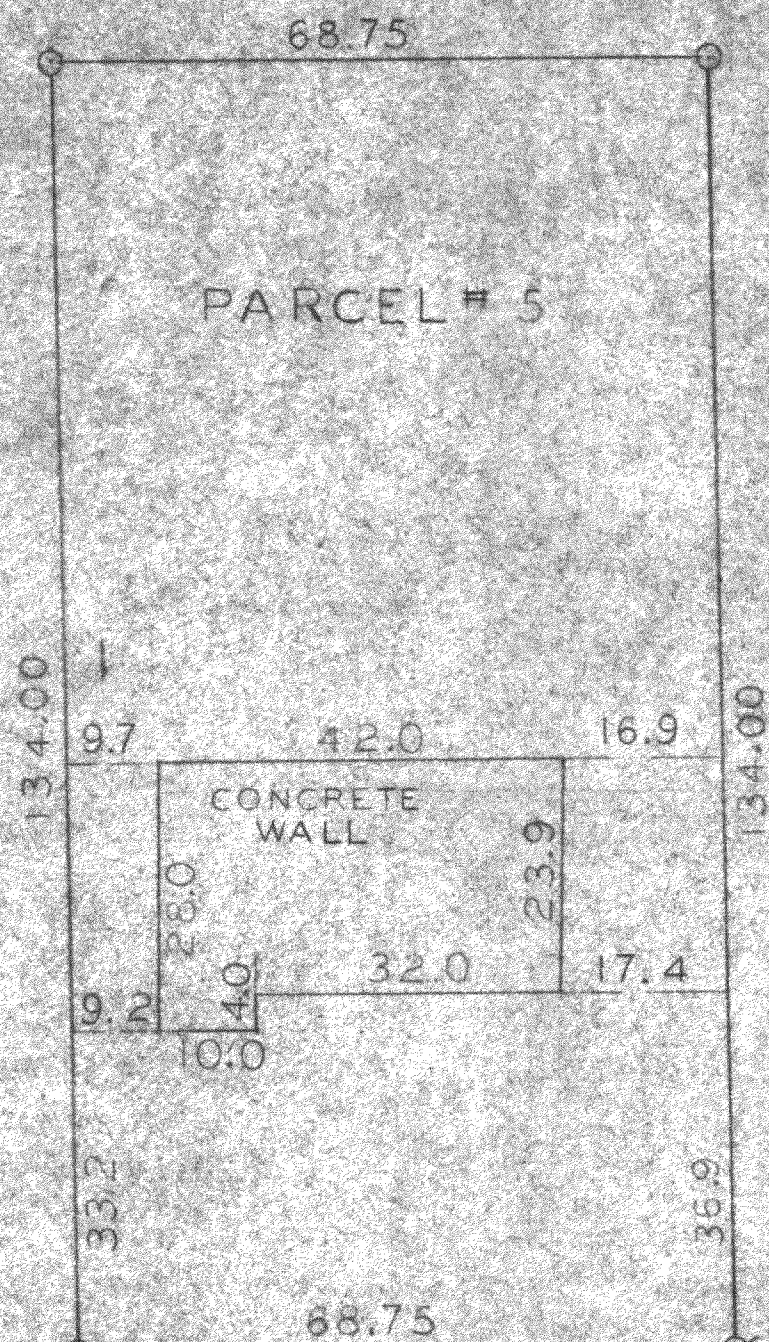

CHURCH STREET

SE CORNER
LOT 1 BLOCK 1
STANFORDS
ADDITION

SECOND

AVENUE

66

PLAT OF SURVEY

OF
LAND IN NE 1/4 OF
SECTION 36 T3N R16E
CITY OF ELKHORN,
WALWORTH COUNTY, WISCONSIN

Lloyd L. Jensen
SURVEYOR

SCALE 1" = 20'

DATE MAY 1956

S-1D

4-40J