
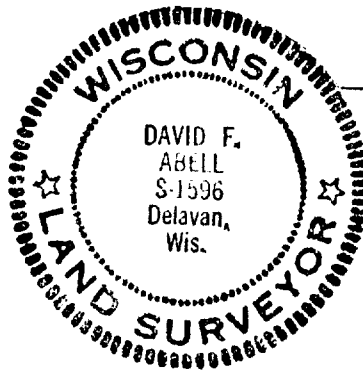


RECEIVED
AUG 8 1986
91.2

BLOCK

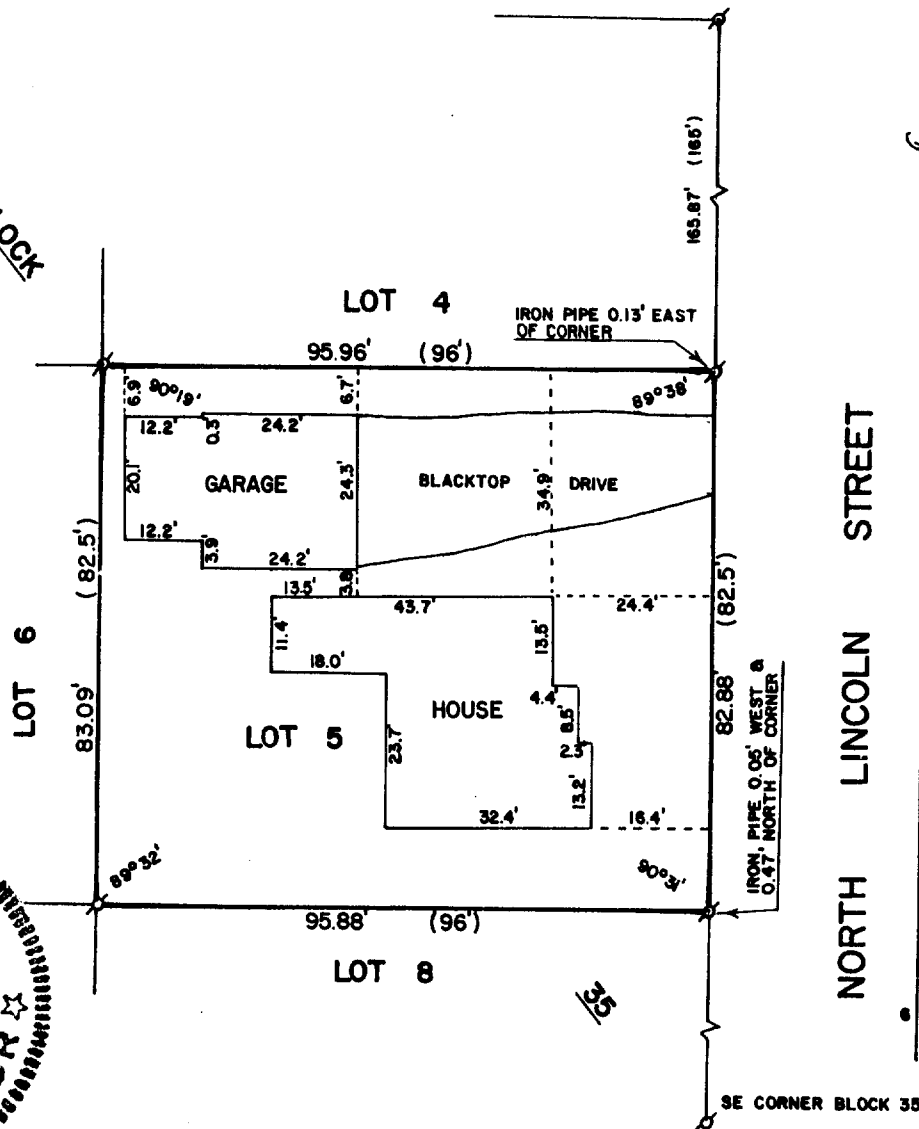

YD-00001C

4411