
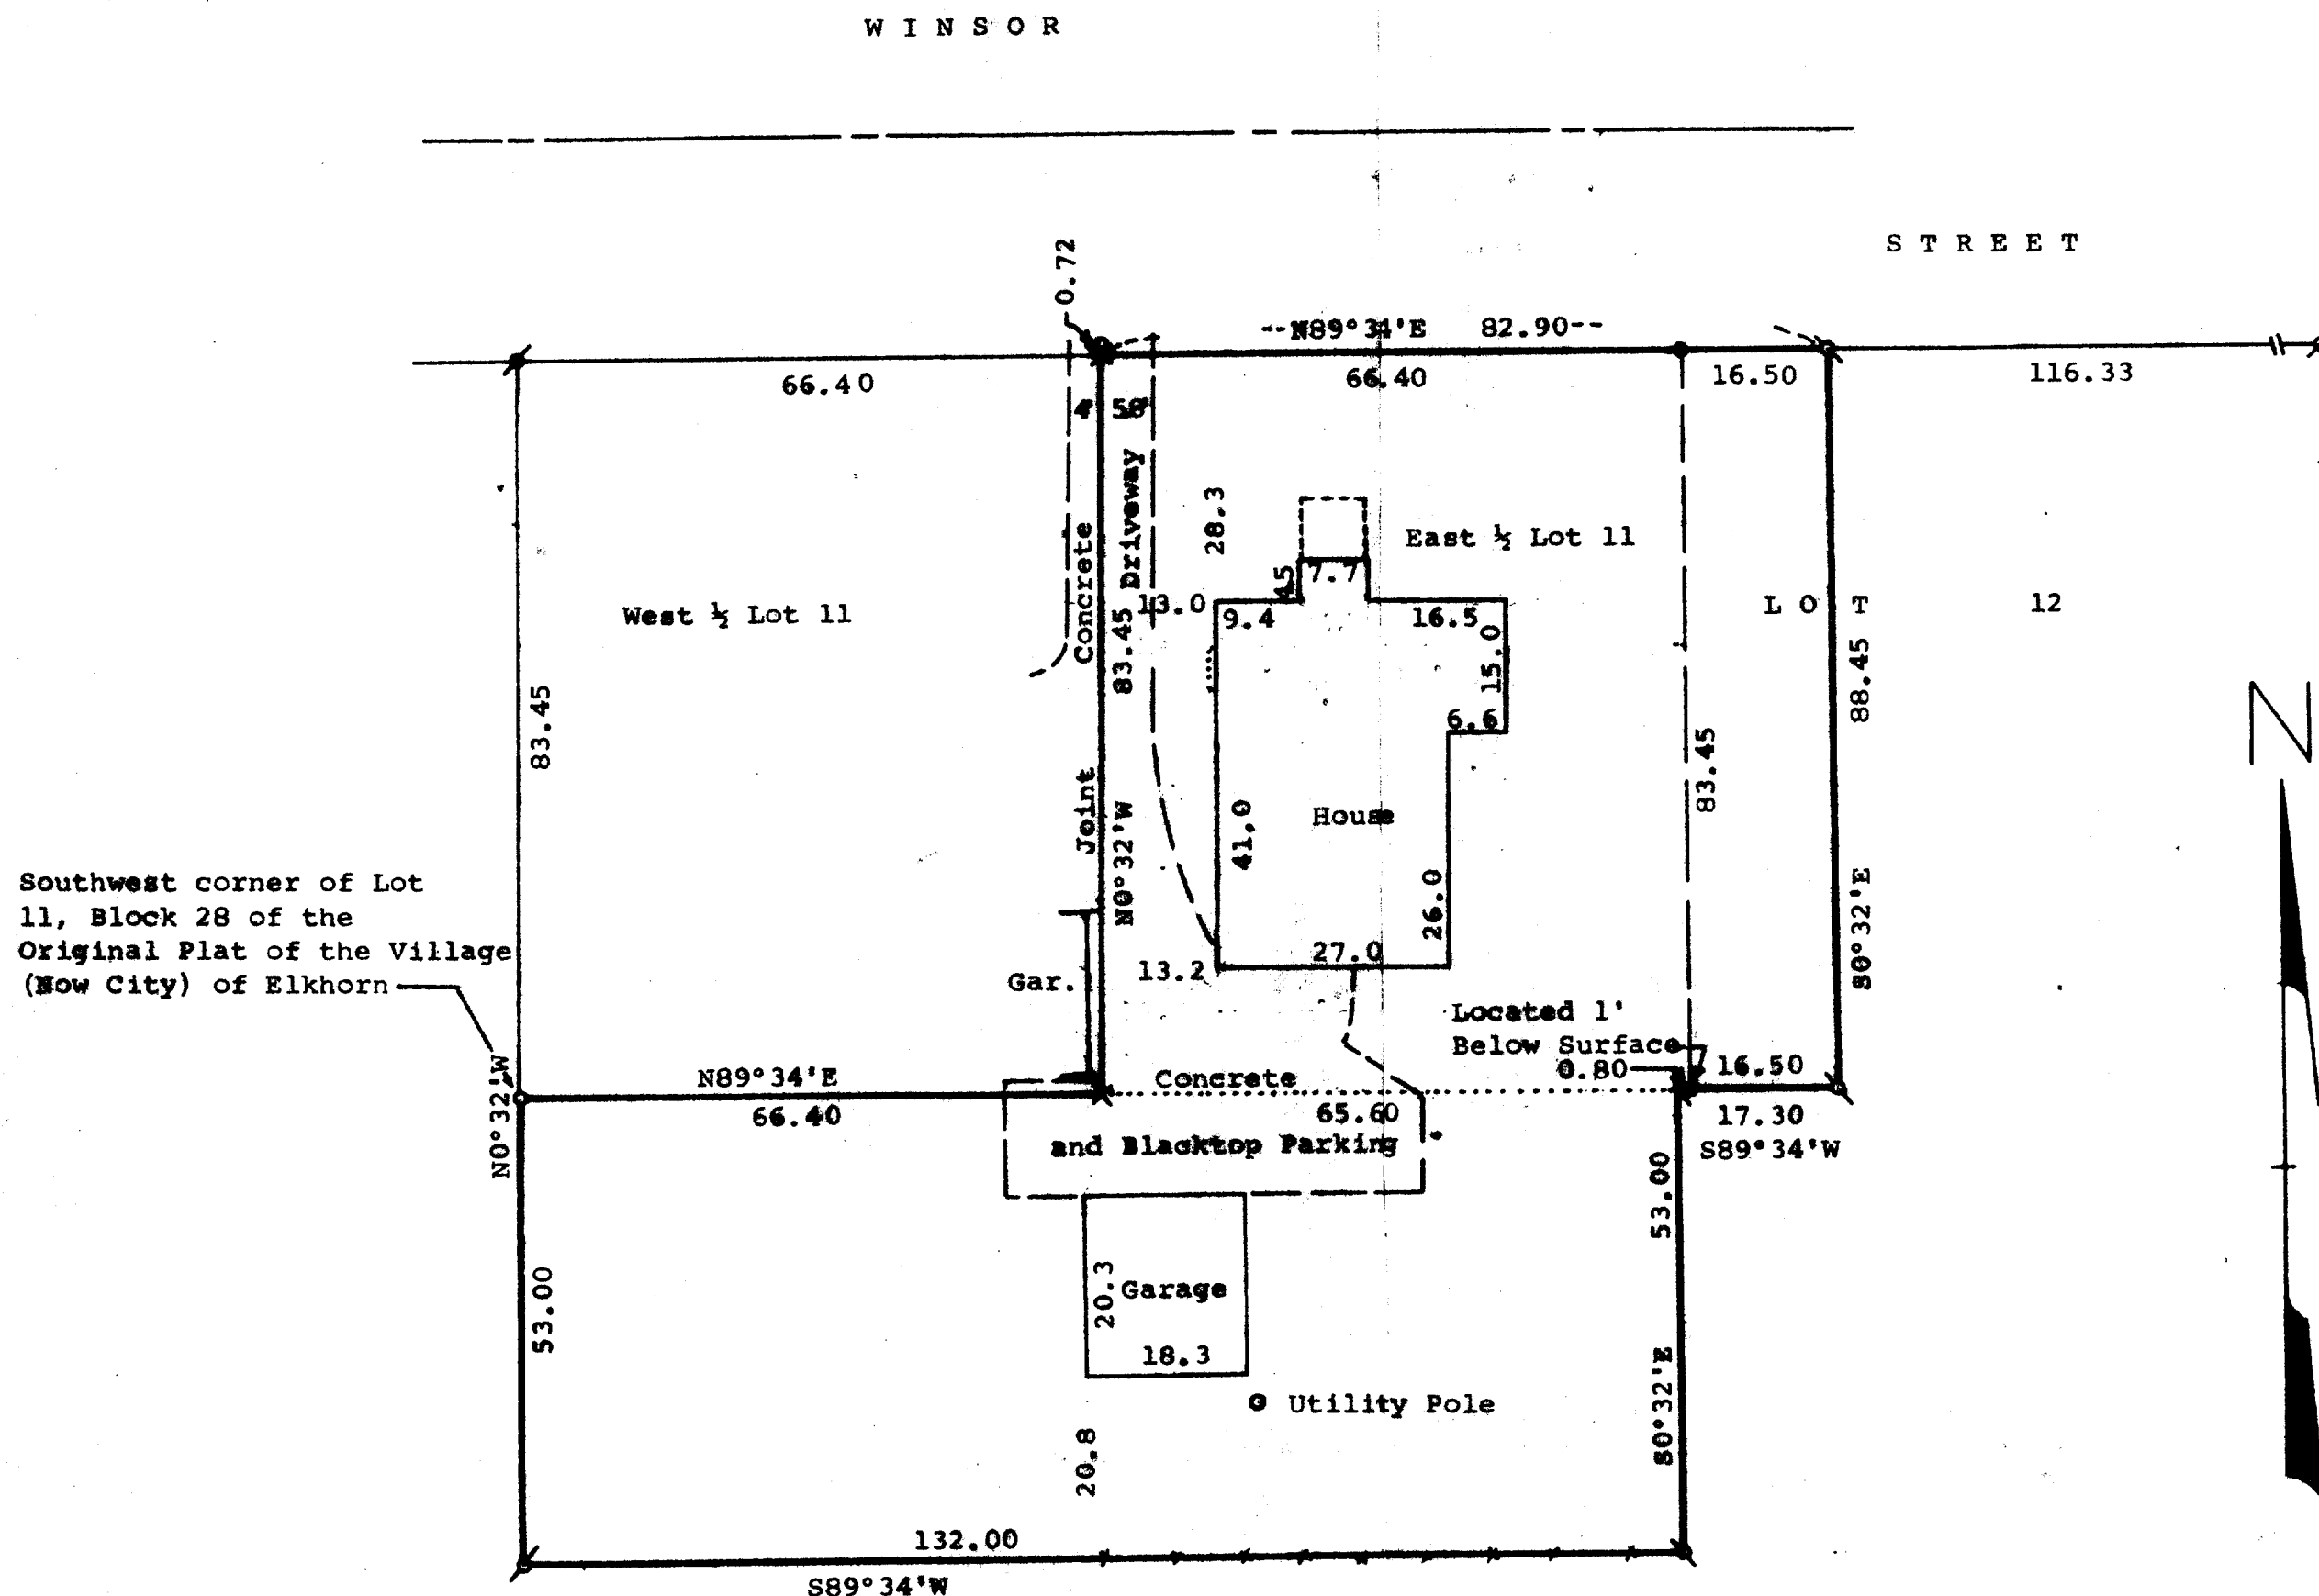


DUNHAM SURVEYING, S.C.
SURVEYING & SUBDIVIDING
DELAVER, WISCONSIN 53115

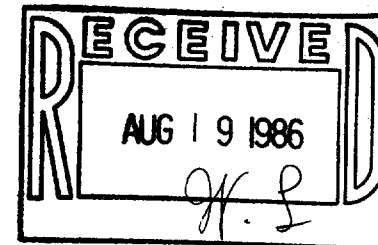

STATE OF WISCONSIN) SS
COUNTY OF WALWORTH)

I, George T. Dunham, Surveyor, certify that I have surveyed the property described as follows:

A parcel of land located in the Southeast 1/4 of Section 36, T 3 N, R 16 E, City of Elkhorn, Walworth County, Wisconsin, described as follows: Beginning at the southwest corner of Lot 11, Block 28 of the Original Plat of the Village (now City) of Elkhorn, thence N89°34'E on the south line of said Lot 11, 132.00 feet; thence S0°32'E parallel with the west line of said plat 53.00 feet; thence S89°34'W parallel with the south line of said Lot 11, 132.00 feet; thence N0°32'W 53.00 feet to the place of beginning,
ALSO The East 1/2 of Lot 11 in Block 28 of the Original Plat of the Village (now City) of Elkhorn, Walworth County, Wisconsin,
ALSO A strip of land 1 rod in width off the entire west side of Lot 12, Block 28 of the Original Plat of the Village (now City) of Elkhorn, Walworth County, Wisconsin,
ALSO All rights which the owners of the above described parcels of land have in and to the Joint Driveway on the west line of said East 1/2 of Lot 11, Block 28 of the Original Plat, City of Elkhorn, Walworth County, WI., as described in the deed from Robert G. Lannon and wife to B. B. Kraus and wife, recorded in Volume 169 of Deeds on Page 35, Walworth County Records.

and that the map shown above is a true representation thereof and shows the size and location of the property, its exterior boundaries, the location of all visible structures and dimensions of all principal buildings thereon, boundary fences, apparent easements, roadways and visible encroachments, if any, and that I have surveyed the property hereon described according to the official records, to the best of my knowledge and belief.
July 24, 1984

George T. Dunham
George T. Dunham, Surveyor

