
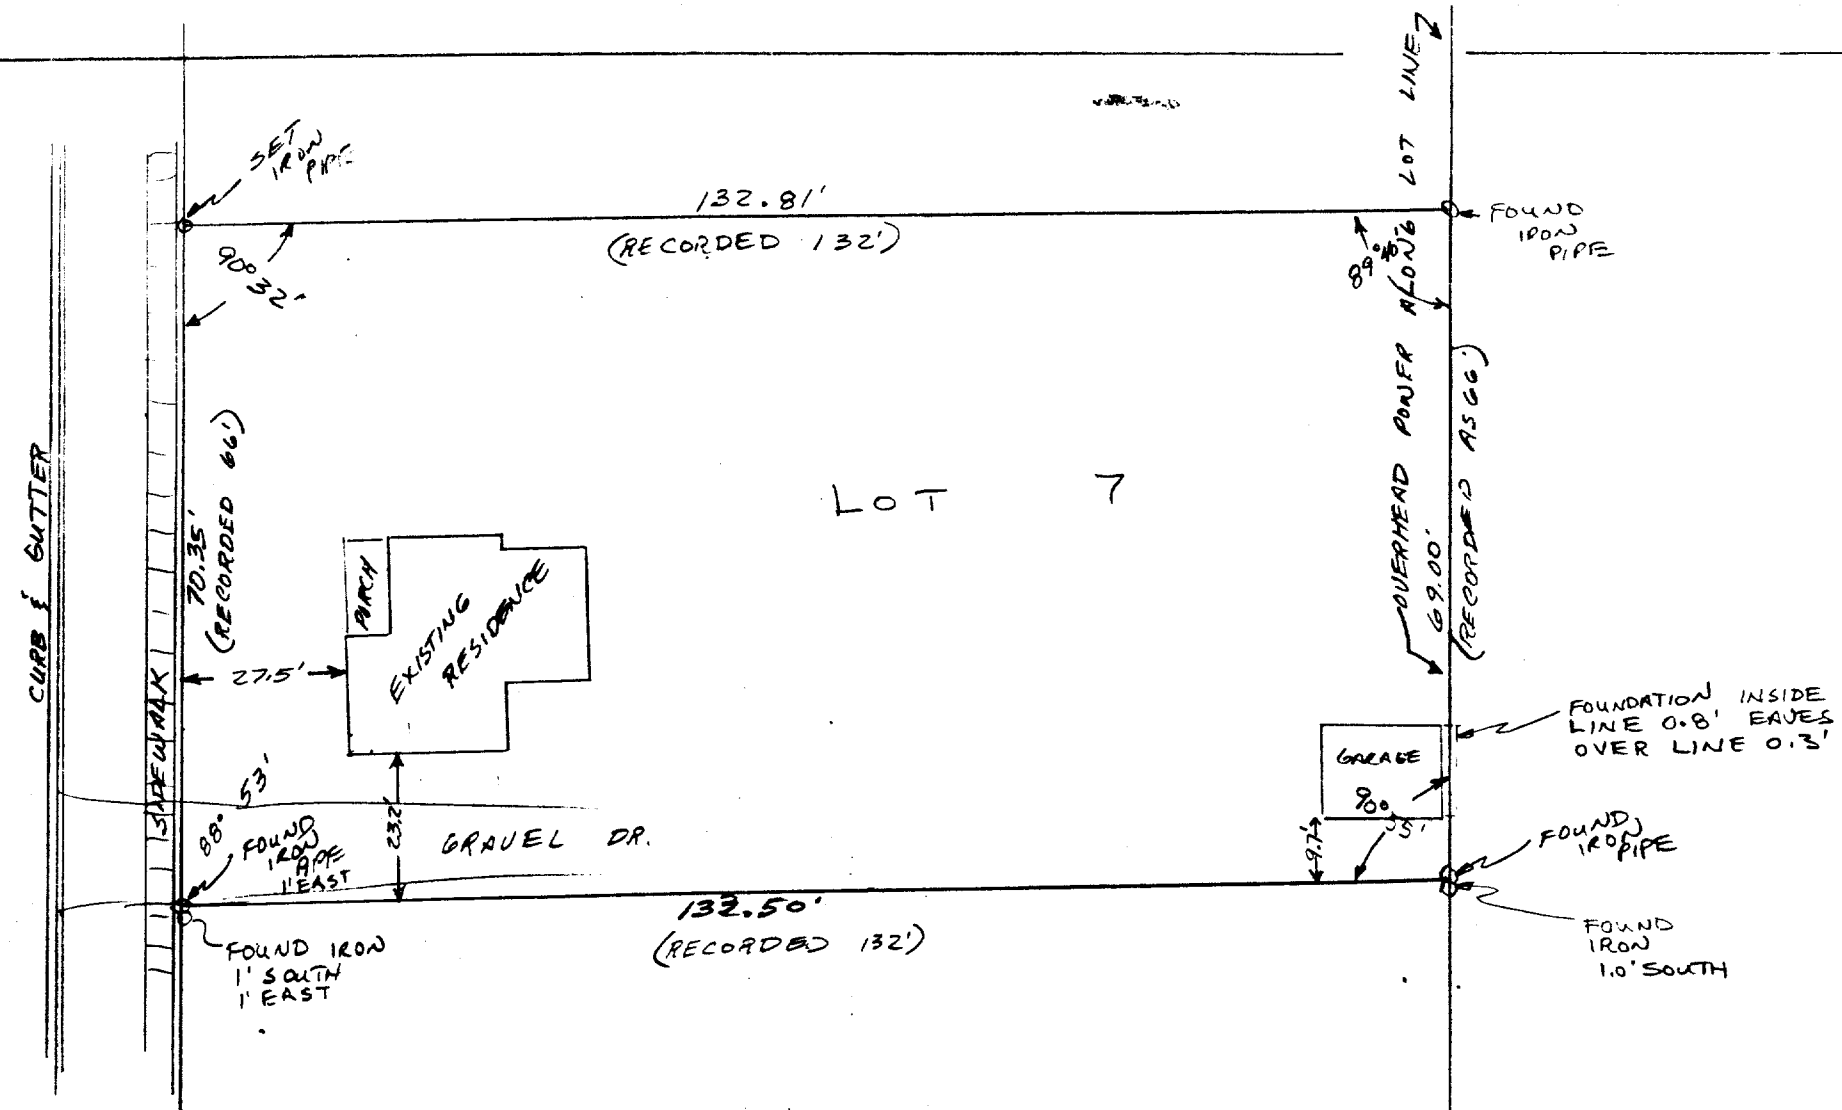


D.D. COOPER & CO. INC.

Route 4 Box 508B
Elkhorn WI 53121
Phone-414-723-6265

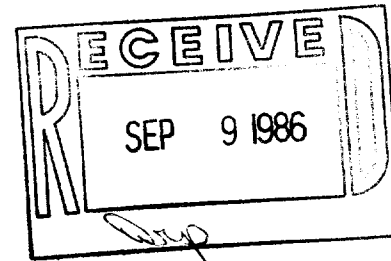


Plat of survey of lot 7 Block 2 Arnolds Addition
located in the City of Elkhorn Walworth County WI

Survey ordered by Hopkins Savings & Loan

I, Daniel D. Cooper, Registered Land Surveyor do hereby certify that
I have surveyed the property described hereon and that the map shown
hereon is a true and accurate representation thereof to the best of my
professional knowledge and belief.

Dated this 23rd day of July, 1986

[Signature: Daniel D. Cooper]
Daniel D. Cooper, RLS NO. S-1464

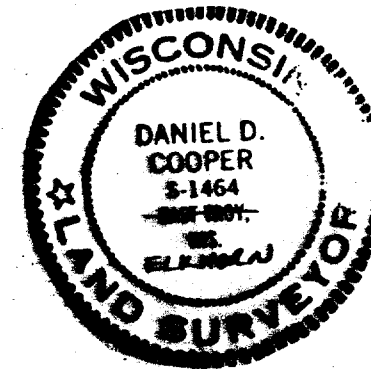

DRAWING NO. 2254-5-34

YAB-14

TAX NO. YAB 00014

YAB-14

