




DATED THIS 23 DAY OF Oct, 1985 *W. Daniel D. Cooper*
DANIEL D. COOPER, RLS NO. S-1464

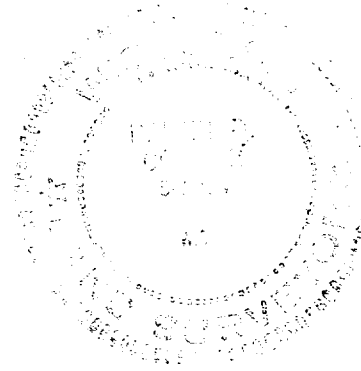

INTERESTING • MODULAR ZONES

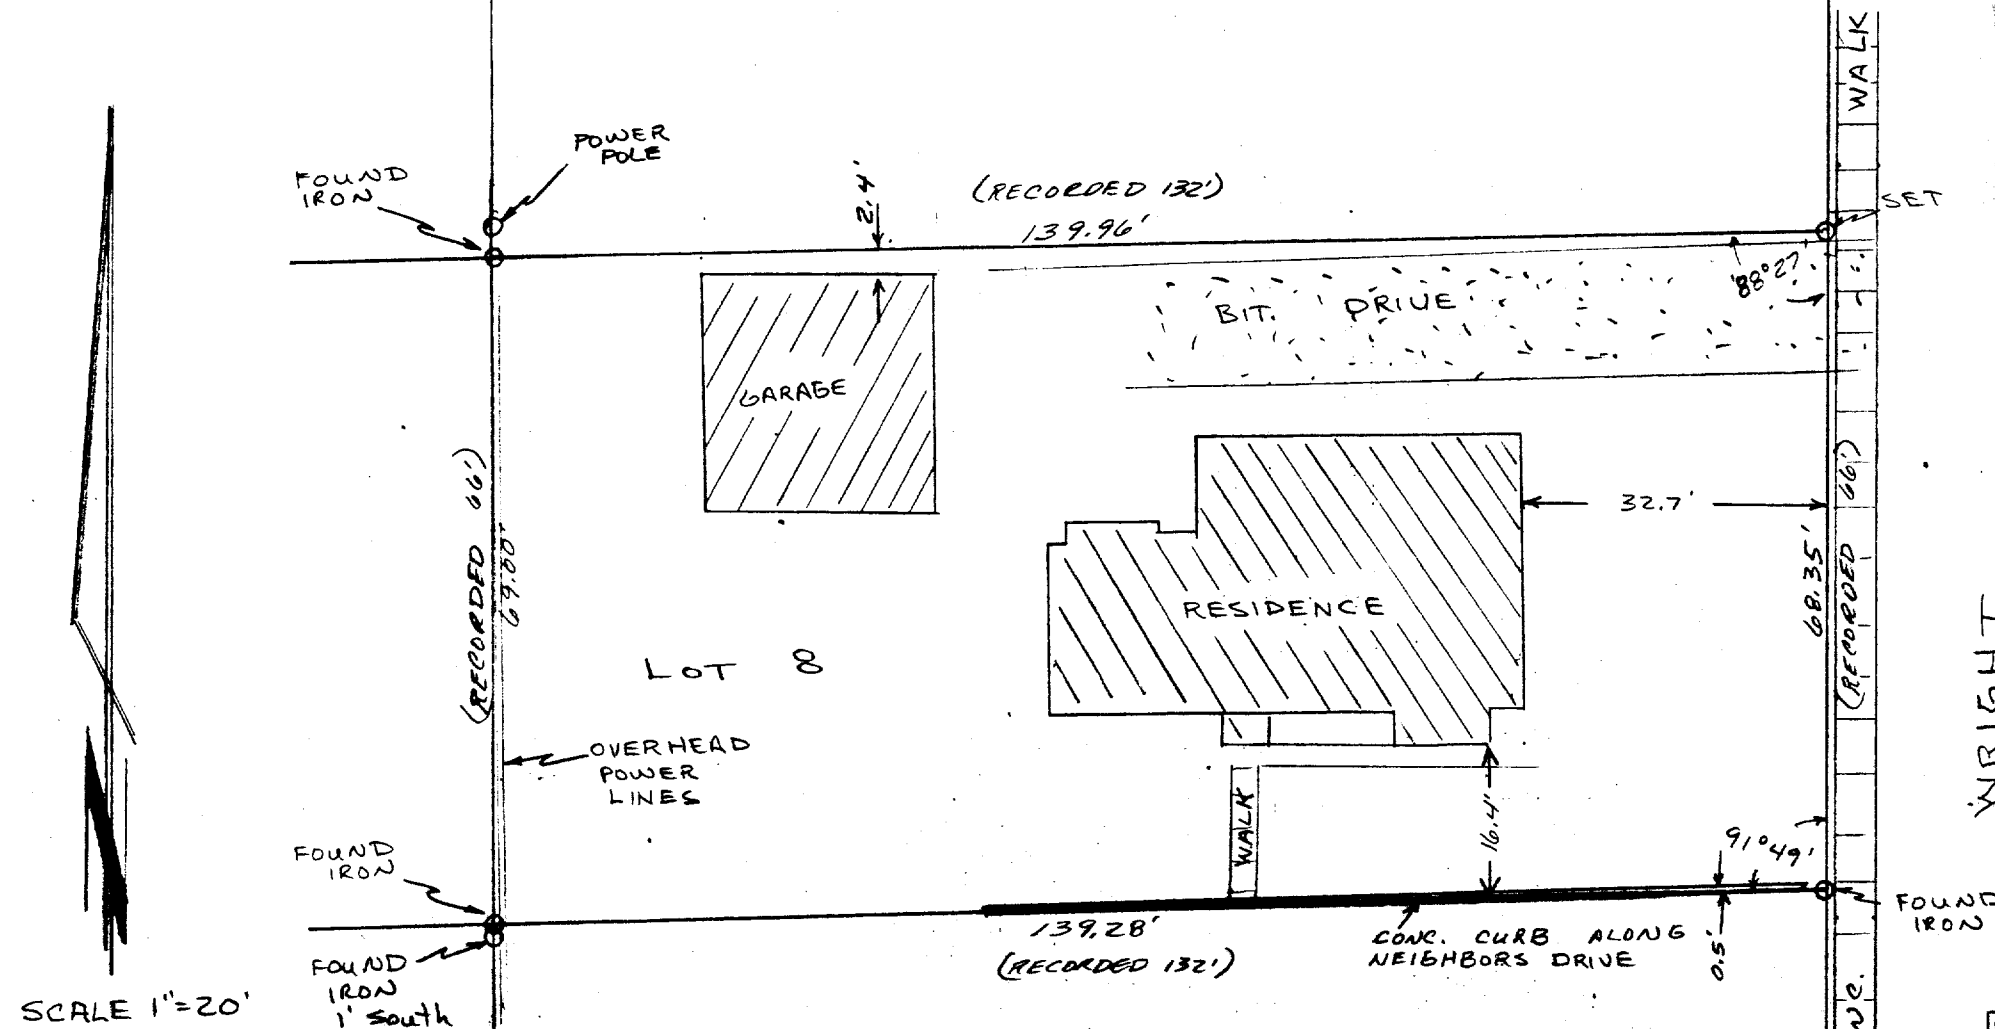

SURVEY ORDERED BY MODERN REALTY

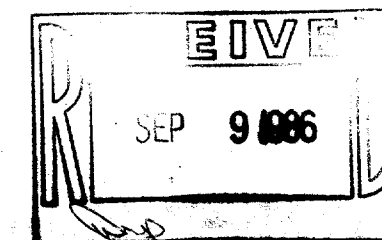

347

