



D.D. COOPER & CO. INC.

Route 4 Box 508B
Elkhorn WI 53121
Phone-414-723-6265

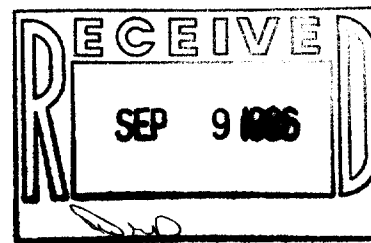

BLOCK 39

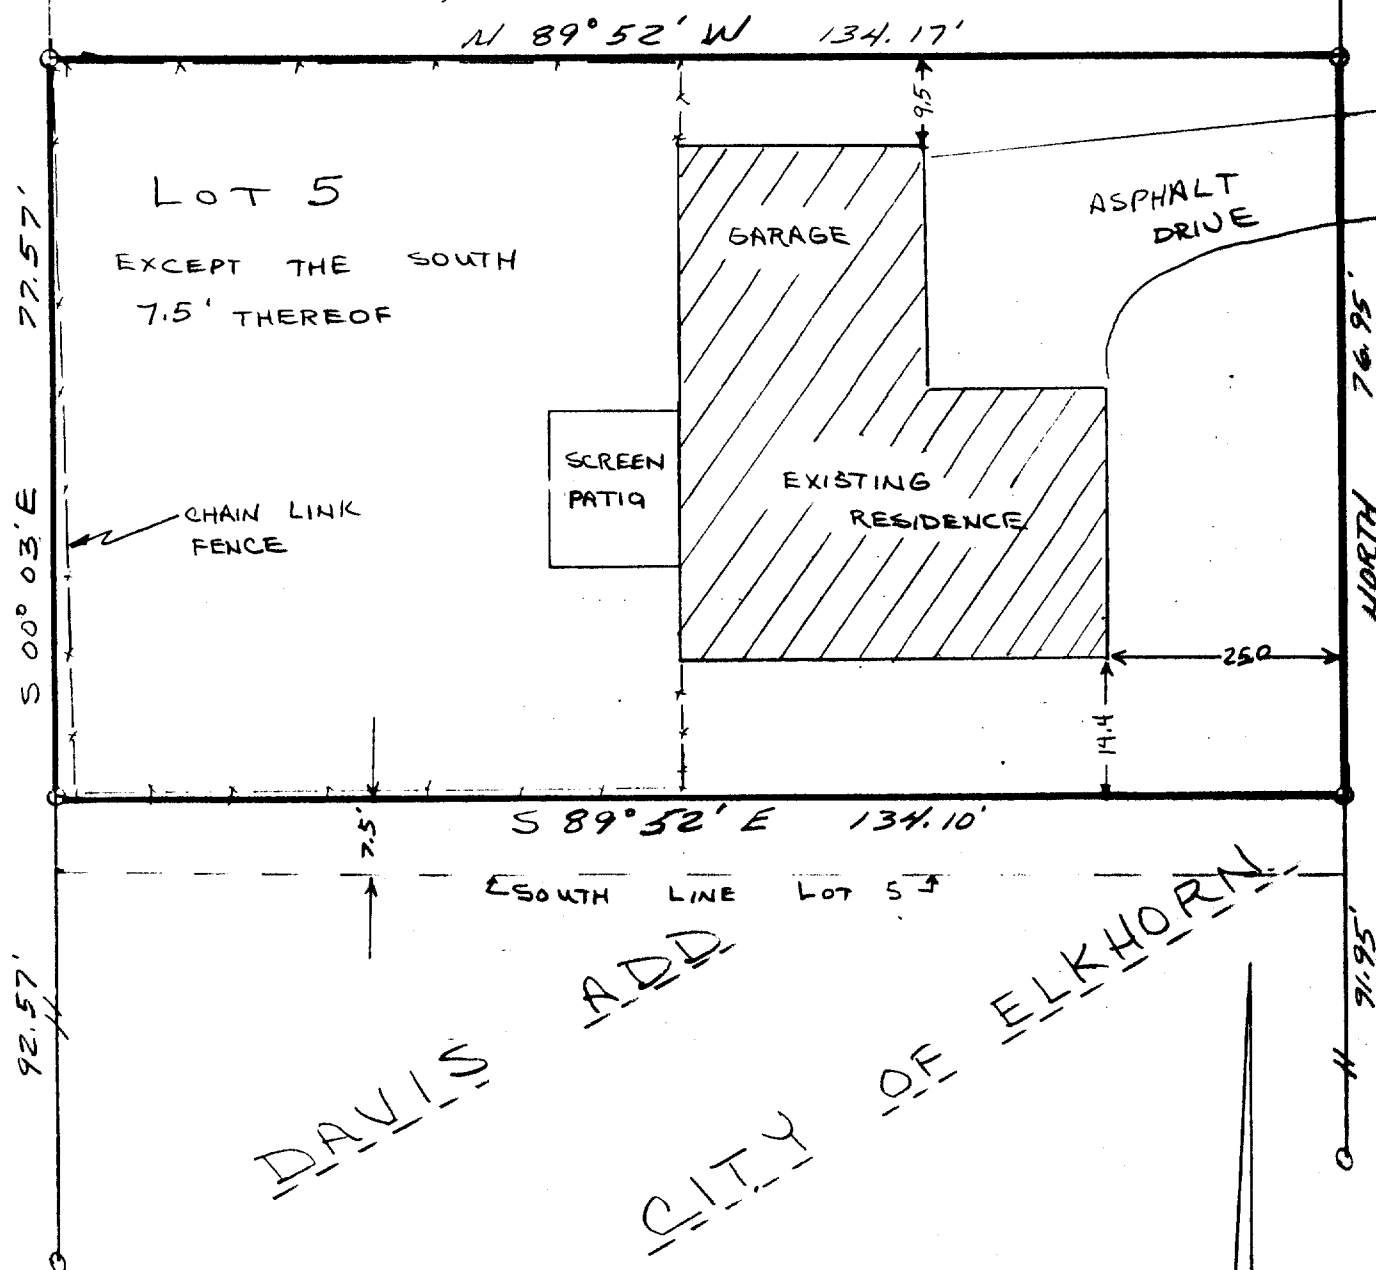

PLAT OF SURVEY OF LOT 5 excepting the southerly 7.5 feet thereof of block 39 Davis Addition to the City of Elkhorn Walworth County Wisconsin


Survey ordered by: Hopkins Savings & Loan
2600 North Mayfair Road
Milwaukee WI

SCALE 1"=20'

I, Daniel D. Cooper, Registered Land Surveyor do hereby certify that I have surveyed the property described hereon and that the map shown hereon is a true and accurate representation thereof to the best of my professional knowledge and belief.

Dated this 1ST day of July, 1986

Daniel D. Cooper
Daniel D. Cooper, RLS NO. S-1464

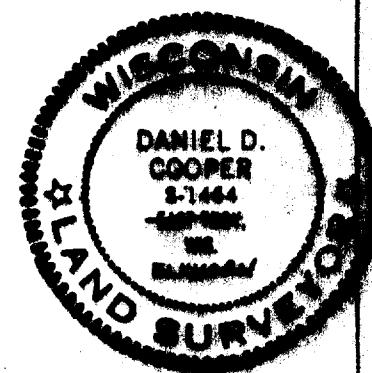

TAX NO. YD 00029

DRAWING NO. 2239-5-29