



#38-63

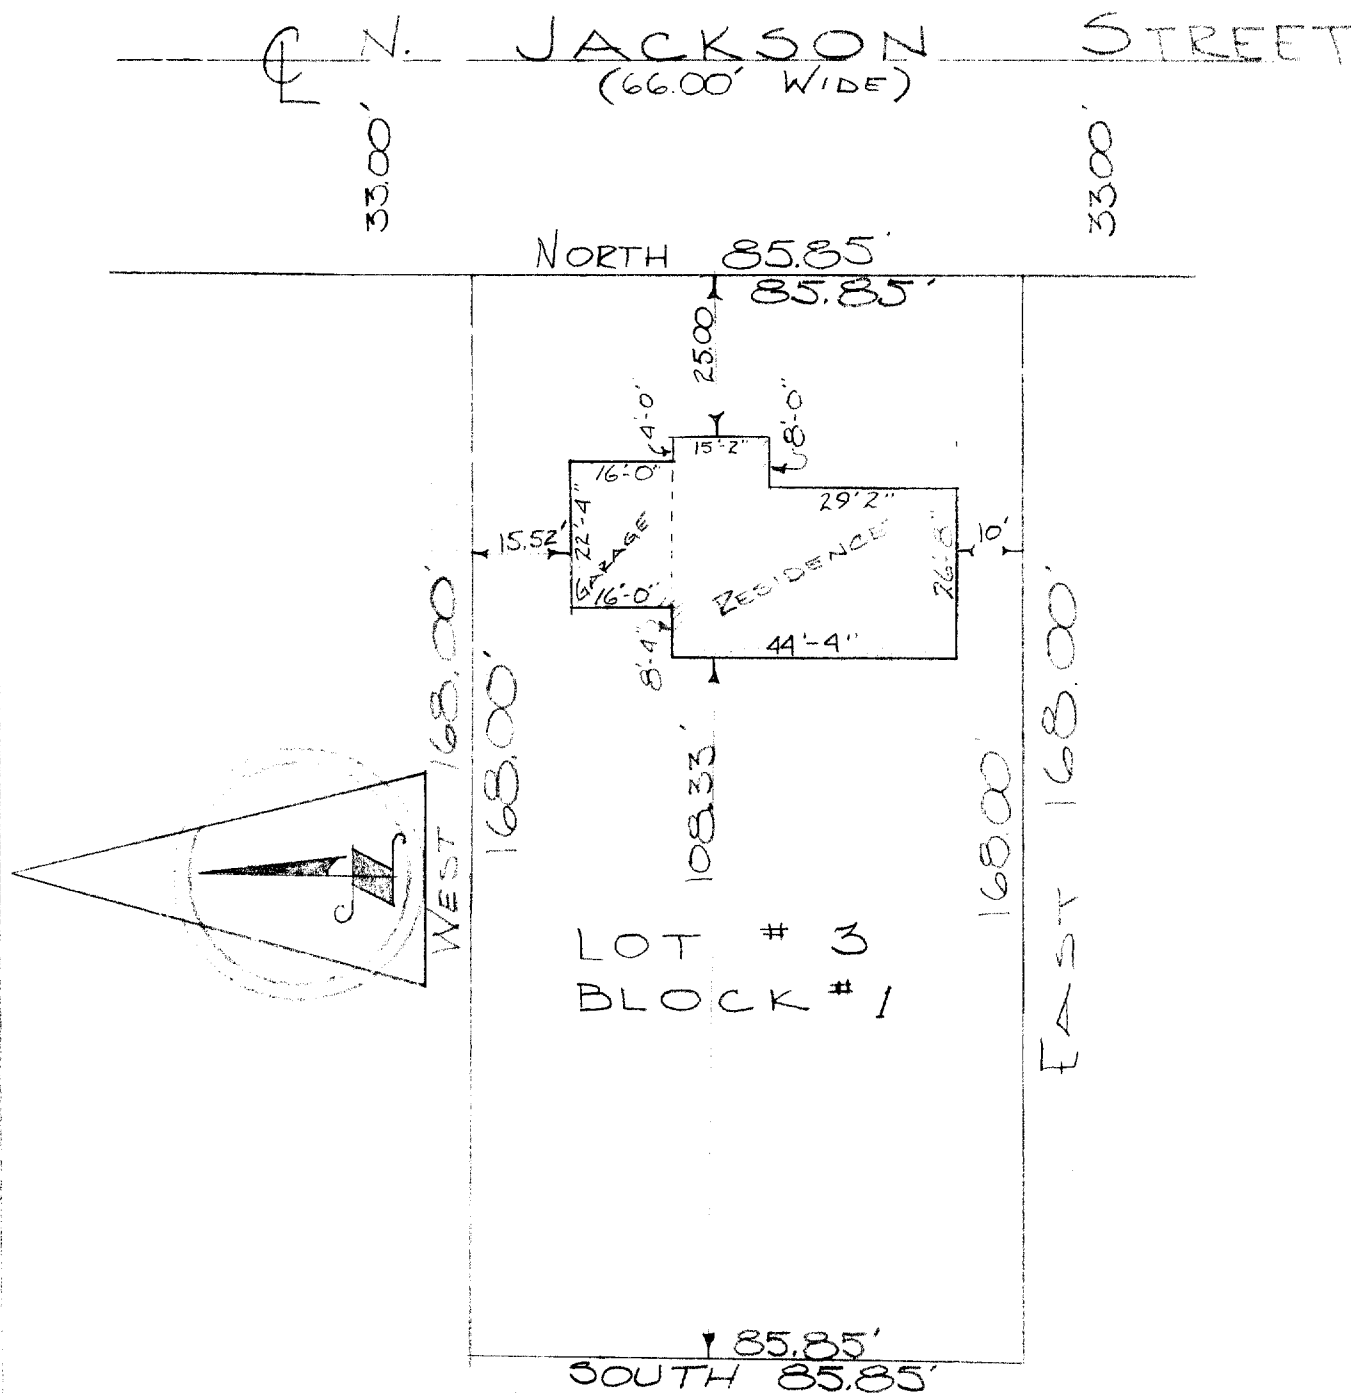

DESCRIPTION: Lot #3 of Block #1 of Fairlane Subdivision, City of Elkhorn, Walworth County, Wisconsin.

CERTIFICATE: I, James F. Biagi, surveyor, do hereby certify that that I have surveyed the property hereon described, and that the location of improvements are as shown.

April 13, 1963.

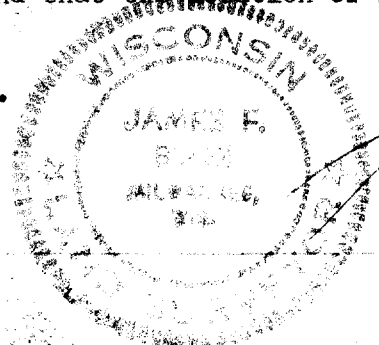

James F. Biagi, RLS 272

YFL3

4-41B