
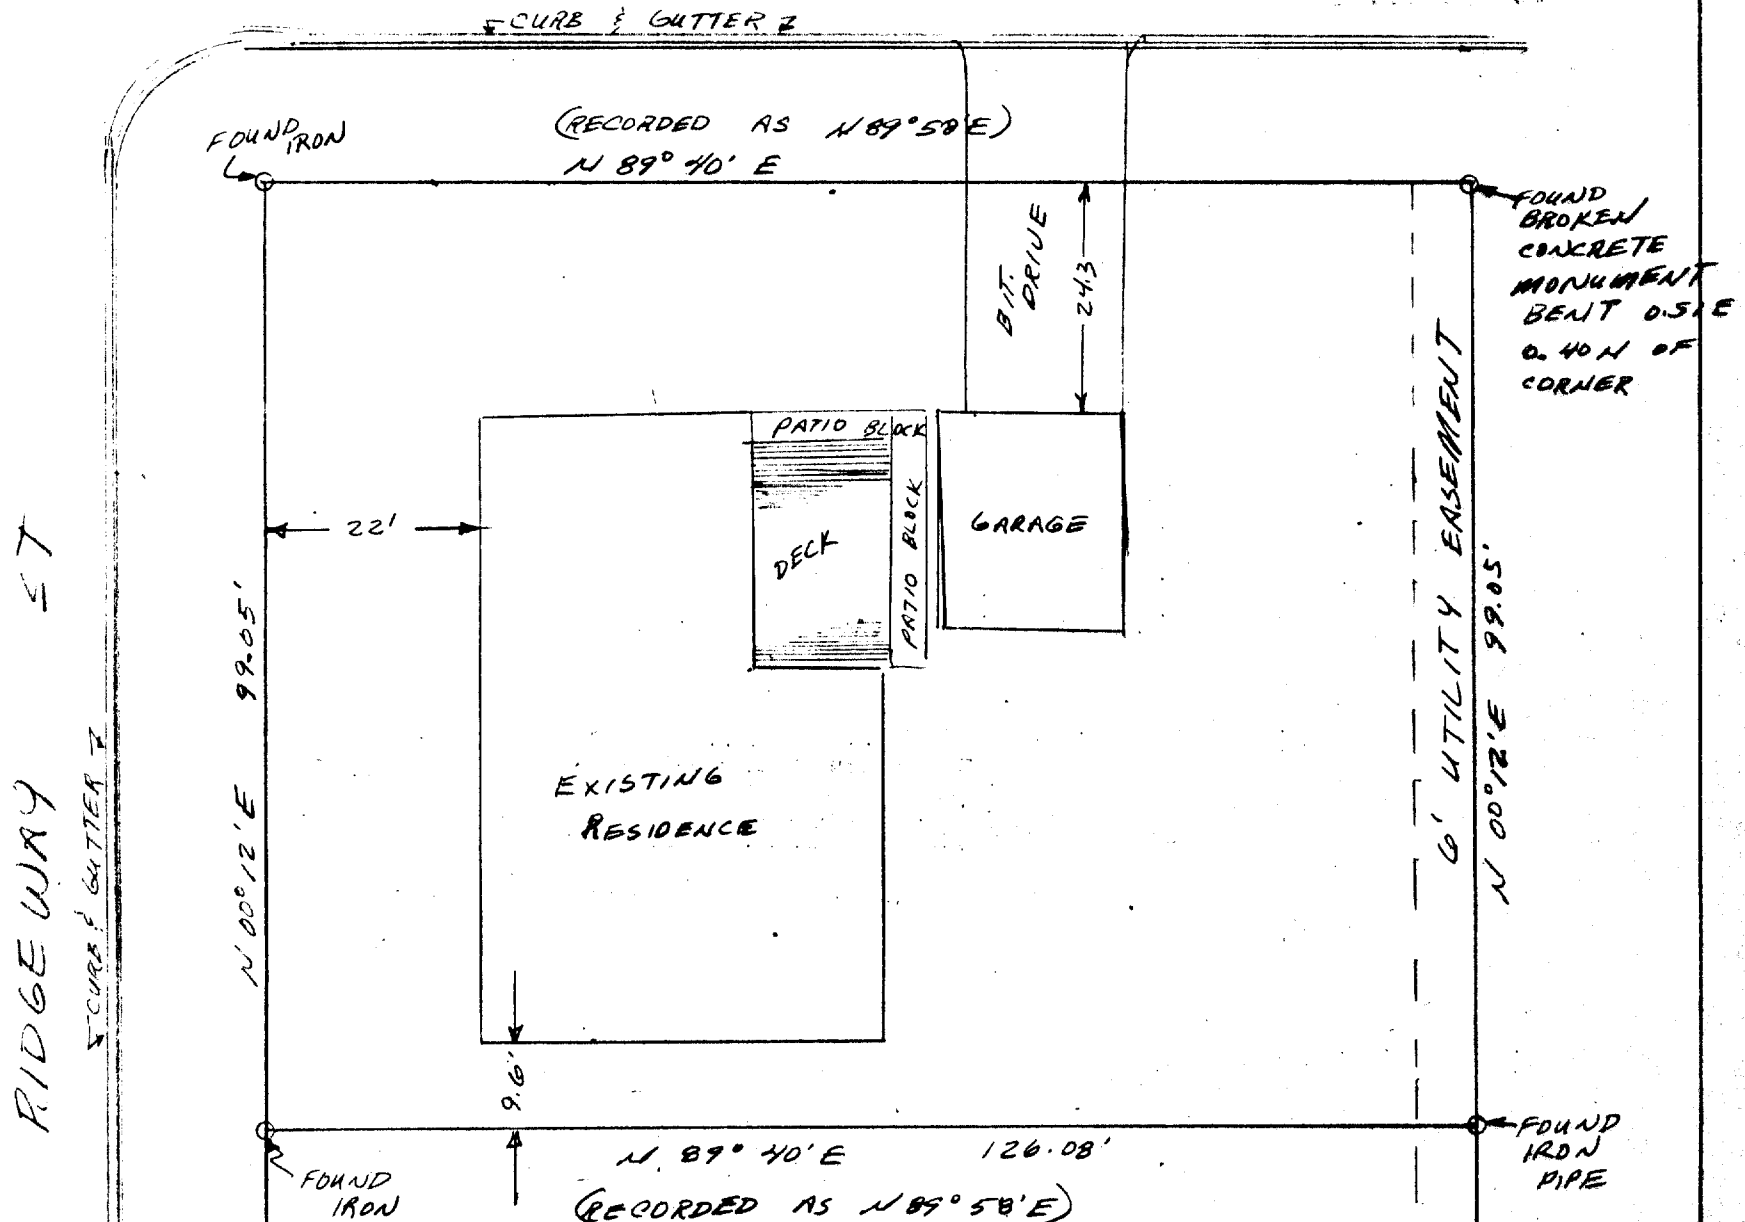


D.D. COOPER & CO. INC.

Route 4 Box 508B
Elkhorn WI 53121
Phone-414-723-6265

COURT STREET

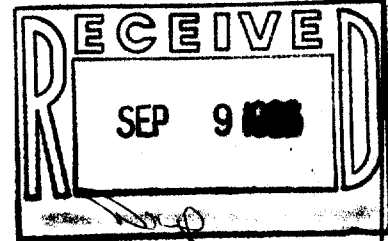

Plat of survey of lot 10 Except the South 1.00 foot thereof of Landmark Subdivision located in the City of Elkhorn Walworth County Wisconsin


Survey ordered by Hopkins Savings & Loan

Bearing reference: Westerly line
of parcel assumed to bear N00 12'E

I, Daniel D. Cooper, Registered Land Surveyor do hereby certify that I have surveyed the property described hereon and that the map shown hereon is a true and accurate representation thereof to the best of my professional knowledge and belief.

Dated this 18TH day of July, 1986

Daniel D. Cooper
Daniel D. Cooper, RLS NO. S-1464

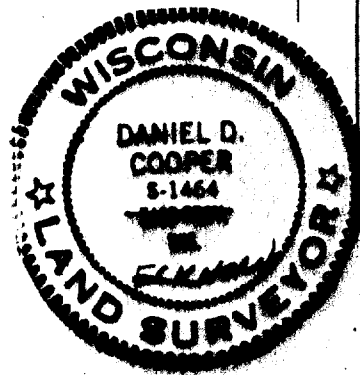

SCALE
1"=20'

DRAWING NO. 2188-4-46

GREY
ELKHORN
TAX PARCEL YLS 00010