
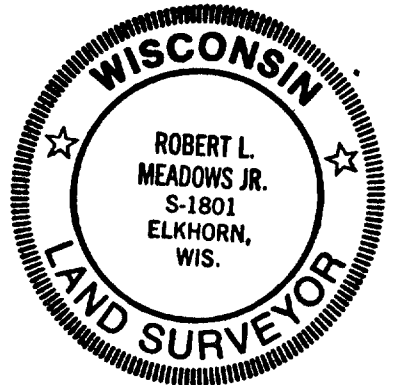
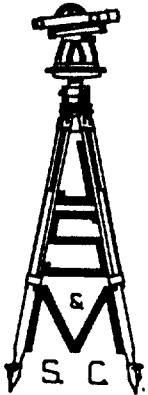


PLAT OF SURVEY

OF LAND LOCATED IN THE S.E. 1/4 OF SECTION 1, T2N, R16E
CITY OF ELKHORN, WALWORTH COUNTY, WISCONSIN

Jensen Surveying & Mapping S.C.
45 S. Wisconsin St. P.O. Box 322
Elkhorn, Wisconsin. 53121
(414) 723-3434

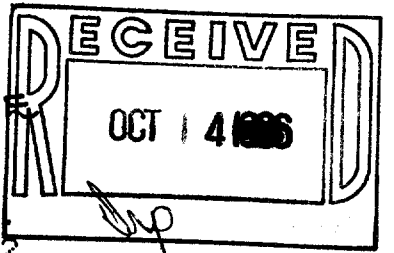


SCALE - 1" = 100'

BEARINGS REFERENCED TO
STATE PLANE COORDINATE SYSTEM
(South Zone)

DESCRIPTION OF CITY OF ELKHORN LAND FILL SITE

A parcel of land located in the S.E. 1/4 of Section 1, T2N, R16E, City of Elkhorn, Walworth County, Wisconsin, described as follows:
Commence at the S.E. Corner of said Section 1; thence N33°33'03"W 1587.19 feet to the point of beginning of the land hereinafter described; thence S89°03'33"W 450.00 feet; thence S0°55'52"E, along the N-S 1/4th Line of the S.E. 1/4, 665.51 feet; thence N89°03'33"E 450.00 feet; thence N0°55'52"W 665.51 feet to the point of beginning. Parcel contains 6.88 acres of land, more or less.

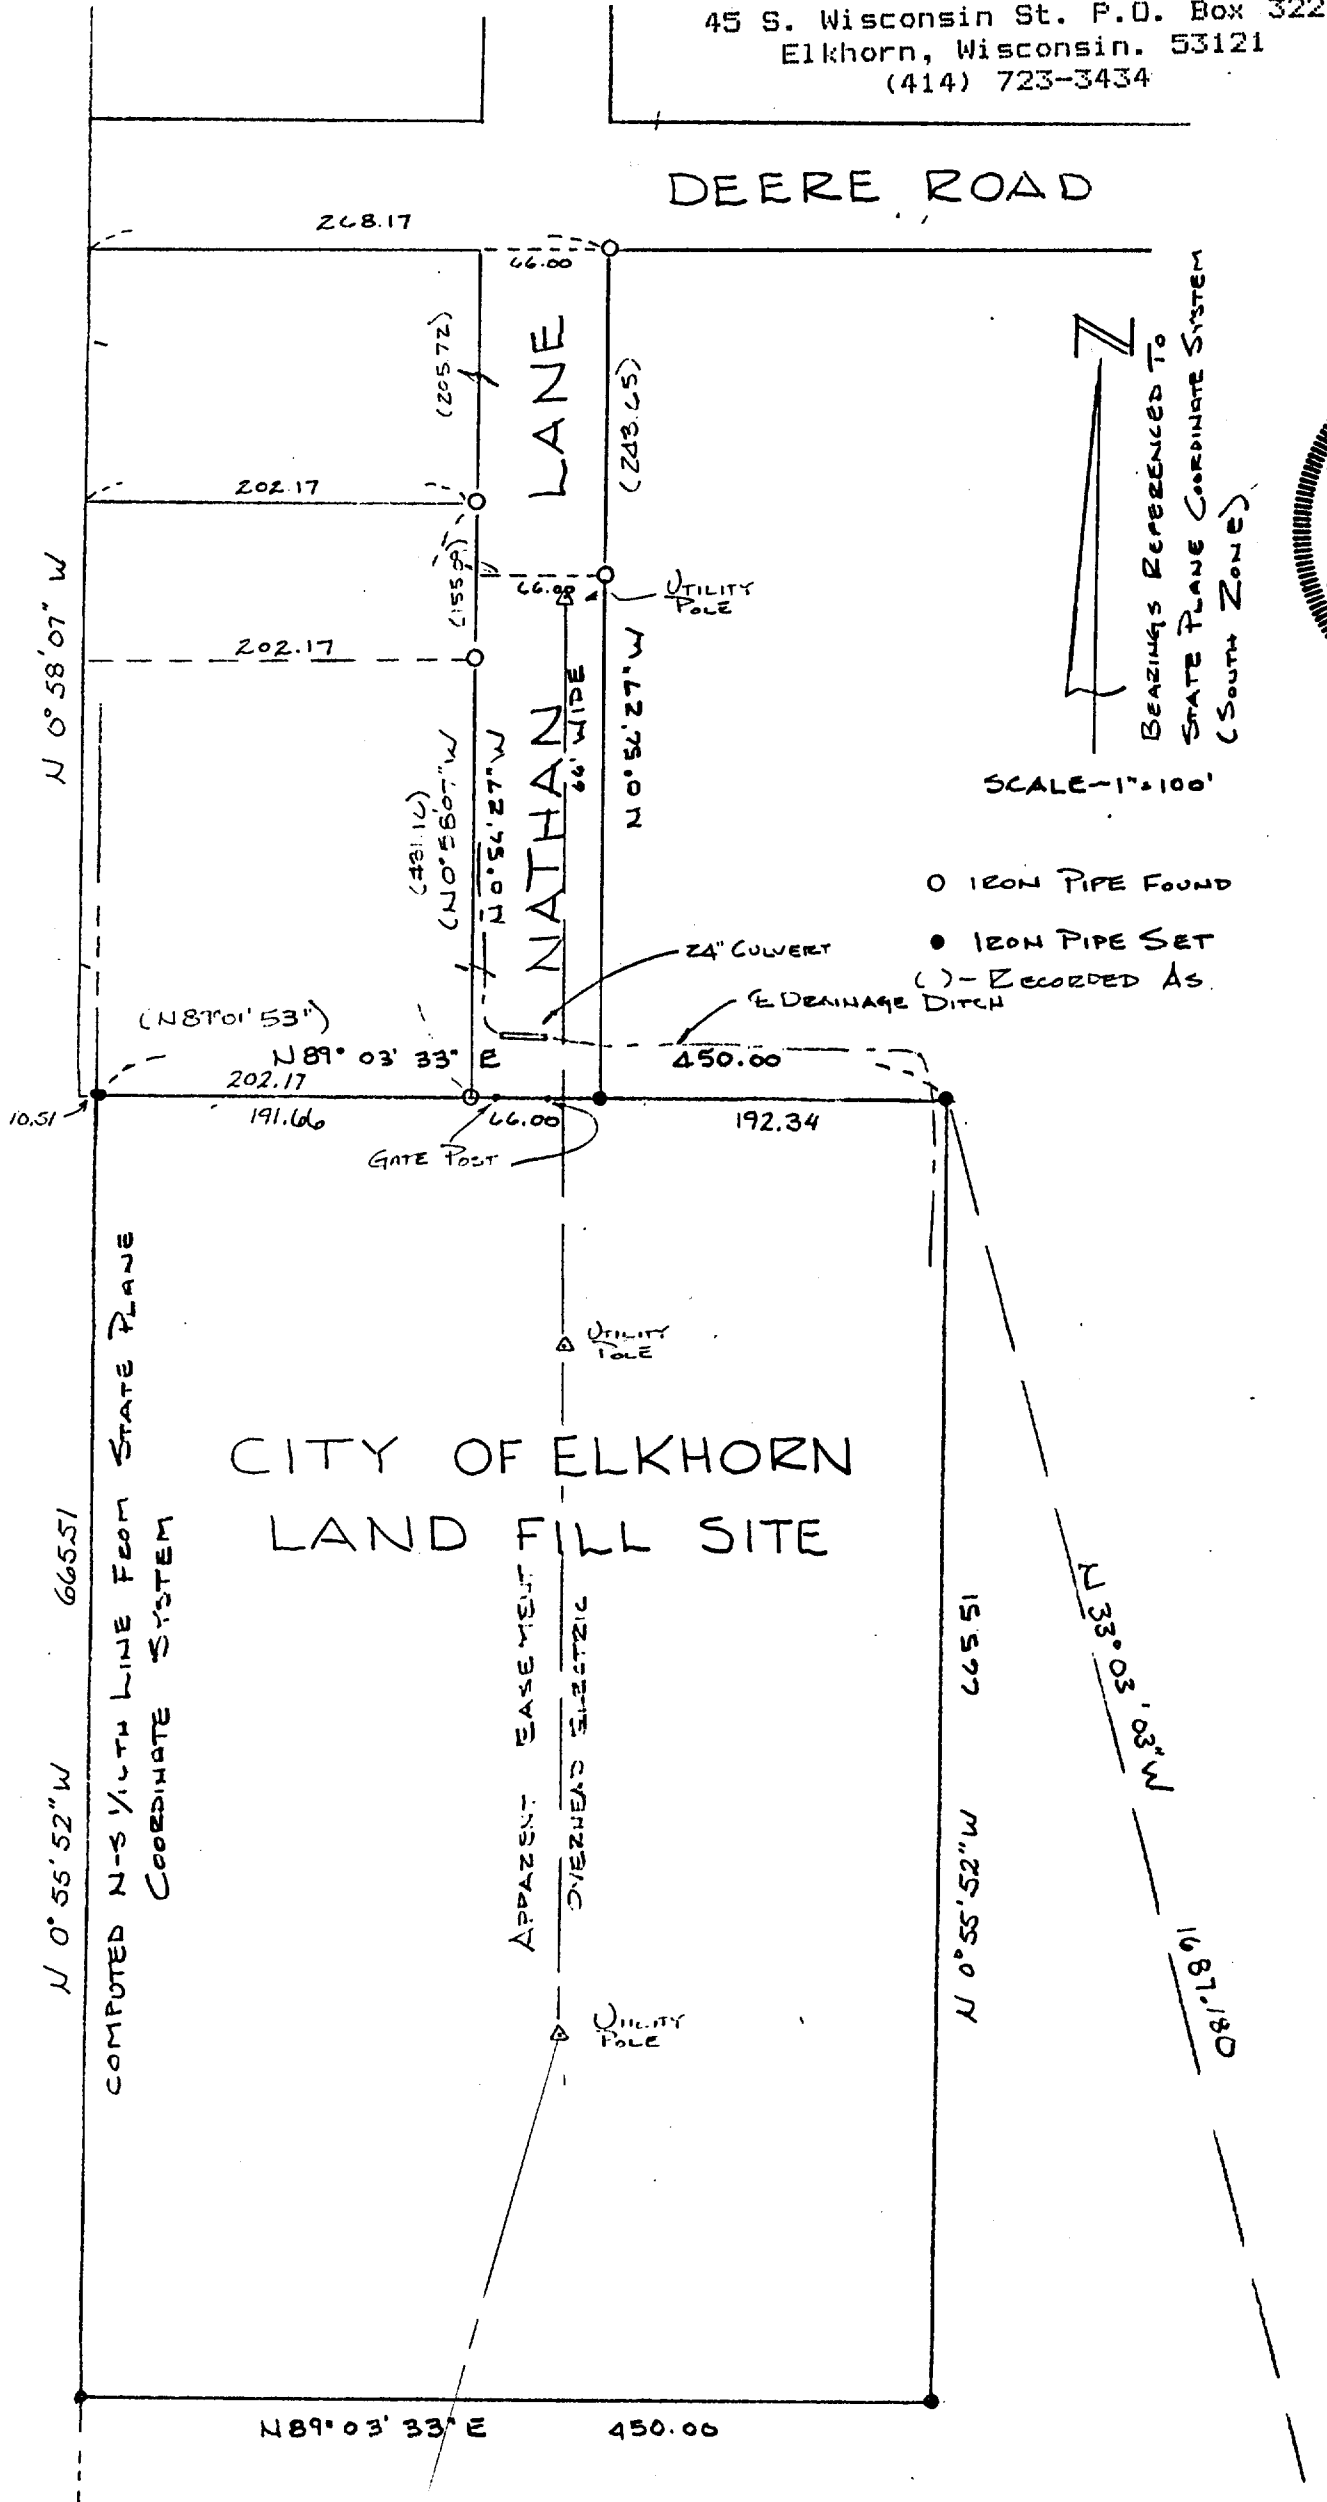

EAST 1/4 CORNER
SECTION 1, T2N, R16E
244,951.82
2,392,387.30

S.E. CORNER
SECTION 1, T2N, R16E
242,305.85
2,392,431.61

I, Robert L. Meadows Jr., Wisconsin Registered Land Surveyor, do hereby certify that this survey was performed by me in full compliance with the owner's/agent's instructions and Chapter AE-5 of the Wisconsin Administrative Code "Minimum Standards for Property Surveys"; and that this map is an accurate representation thereof to the best of my knowledge and belief.

Robert L. Meadows Jr.
Robert L. Meadows Jr. S-1801

MAPPING DATE: 10/24/85

1985.096

1985.096

4-433