

PLAT FOR BUILDING PERMIT

~of~

CERTIFIED SURVEY MAP NO. , A REDIVISION OF LOTS 6, 7, AND 10 OF
ROCKWELL'S ADDITION TO THE CITY OF ELKHORN,
WALWORTH COUNTY, WISCONSIN.

JENSEN SURVEYING & MAPPING S.C.


45 S. WISCONSIN ST. P.O. BOX 322
ELKHORN, WISCONSIN. 53121

BEARINGS REFERENCED TO THE EAST LINE OF
LINCOLN ST. RECORDED AS NORTH

N

1"=20'

SURVEYED FOR: EARL PADDOCK

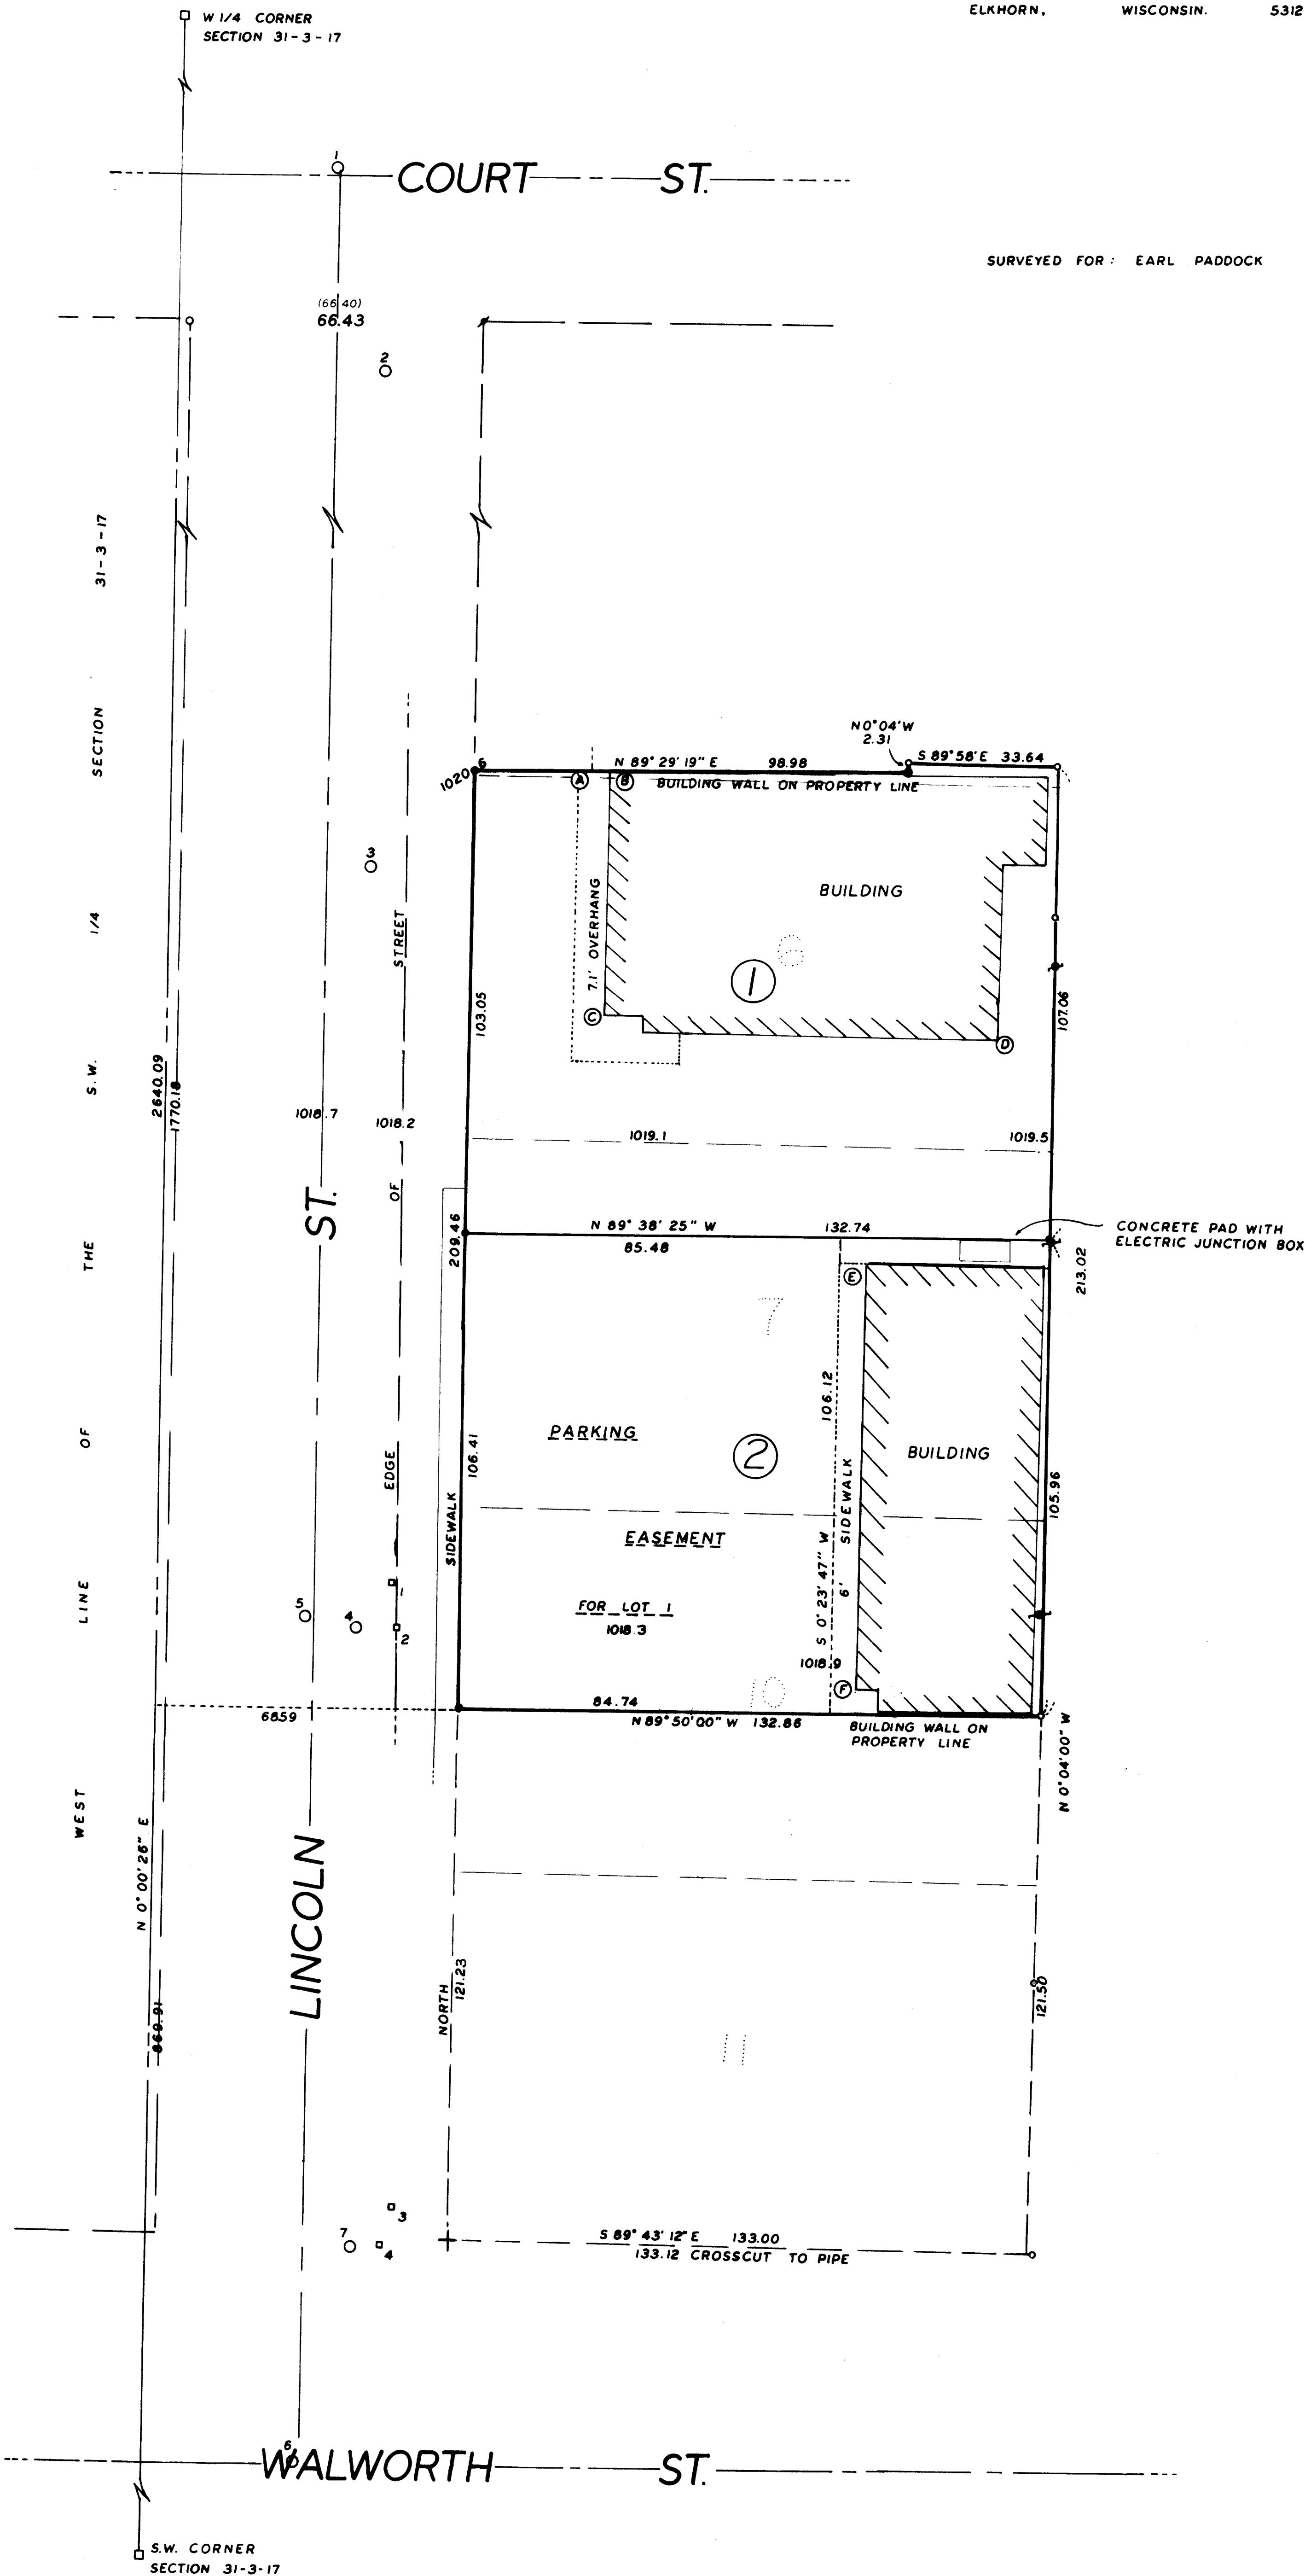

LEGEND

- - FOUND IRON PIPE
- ✚ - FOUND CHISEL CROSSCUT
- ✚ - FOUND SPIKE
- - SET IRON ROD

- ✚ - POWER POLE
- - MANHOLE
- - CATCH BASIN

ELEVATIONS TAKEN 6-26-86

DECIMAL POINT IN NUMERICAL FIGURE
INDICATES LOCATION OF ELEVATION
UNLESS OTHERWISE NOTED.

ELEVATIONS

MANHOLES

- 1 - RIM = 1023.80
FLOW S. = 1013.66
FLOW N. = 1013.66
- 2 - RIM = 1023.31
FL. = 1015.09
- 3 - RIM = 1019.65
FL. N. = 1014.54
FL. S. = 1014.51
- 4 - RIM = 1017.79
FL. = 1012.90
- 5 - RIM = 1018.07
FL. N. = 1012.78
FL. S. = 1012.78
- 6 - RIM = 1018.31
FL. N. = 1012.59
FL. S. = 1012.29
- 7 - RIM = 1017.51
FL. N. = 1013.19
FL. S. = 1013.19

SANITARY

STORM

STORM

STORM

SAN.

SAN.

STORM

CATCH BASINS

- 1 - RIM = 1017.37
FL. = 1012.29
- 2 - RIM = 1017.50
FL. = 1012.54
- 3 - RIM = 1017.08
FL. = 1012.94
- 4 - RIM = 1017.06
FL. = 1011.33

GROUND AT BUILDING CORNERS

- A 1022.2
- B 1020.9
- C 1019.6
- D 1019.6
- E 1019.3
- F 1019.3