


71-61

854-12

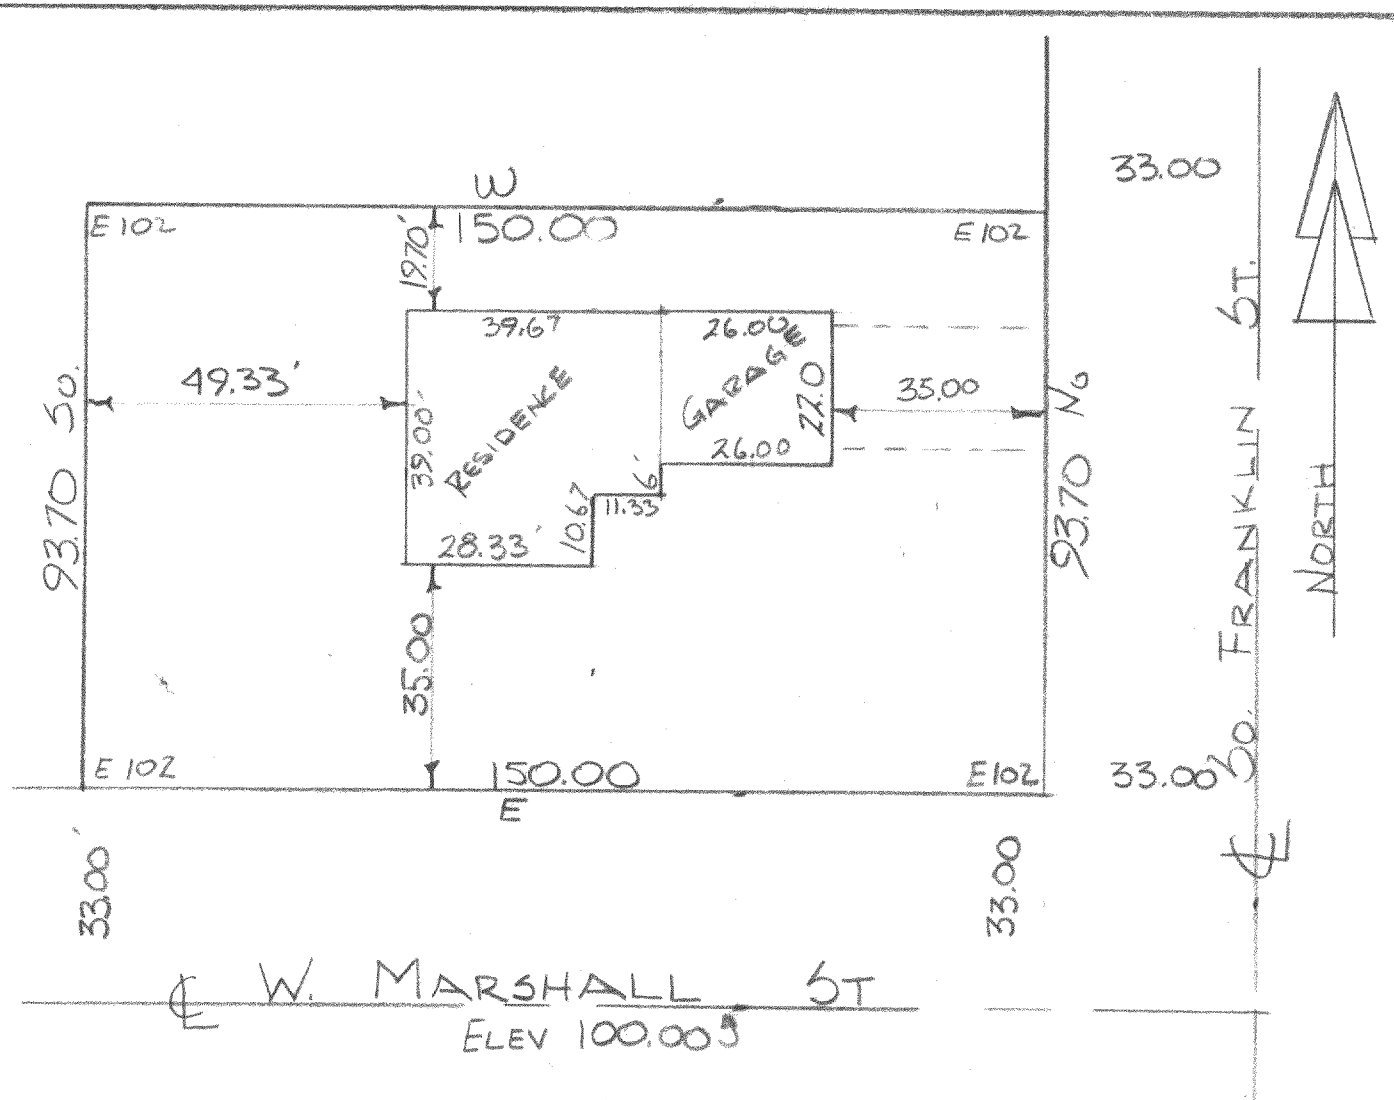

DESCRIPTION:

The South 93.70 feet of Lot 1, Block 5 James Jones 2nd Second Addition and the South 93.70 feet of the East 42.94 feet of Lot 2, Block 5 James Jones 2nd Addition, both additions being to the City of Elkhorn, Walworth County, Wisconsin

CERTIFICATE:

I, James F. Biagi, Surveyor do hereby certify, that I have surveyed the property hereon described and that the location of the improvements are as shown hereon.

SIGNED AND SEALED ON THIS THE 22ND DAY OF FEBRUARY 1961.

James F. Biagi
James F. Biagi, Surveyor.
Elkhorn, Wisconsin.

YJA 2-64

4-42B