


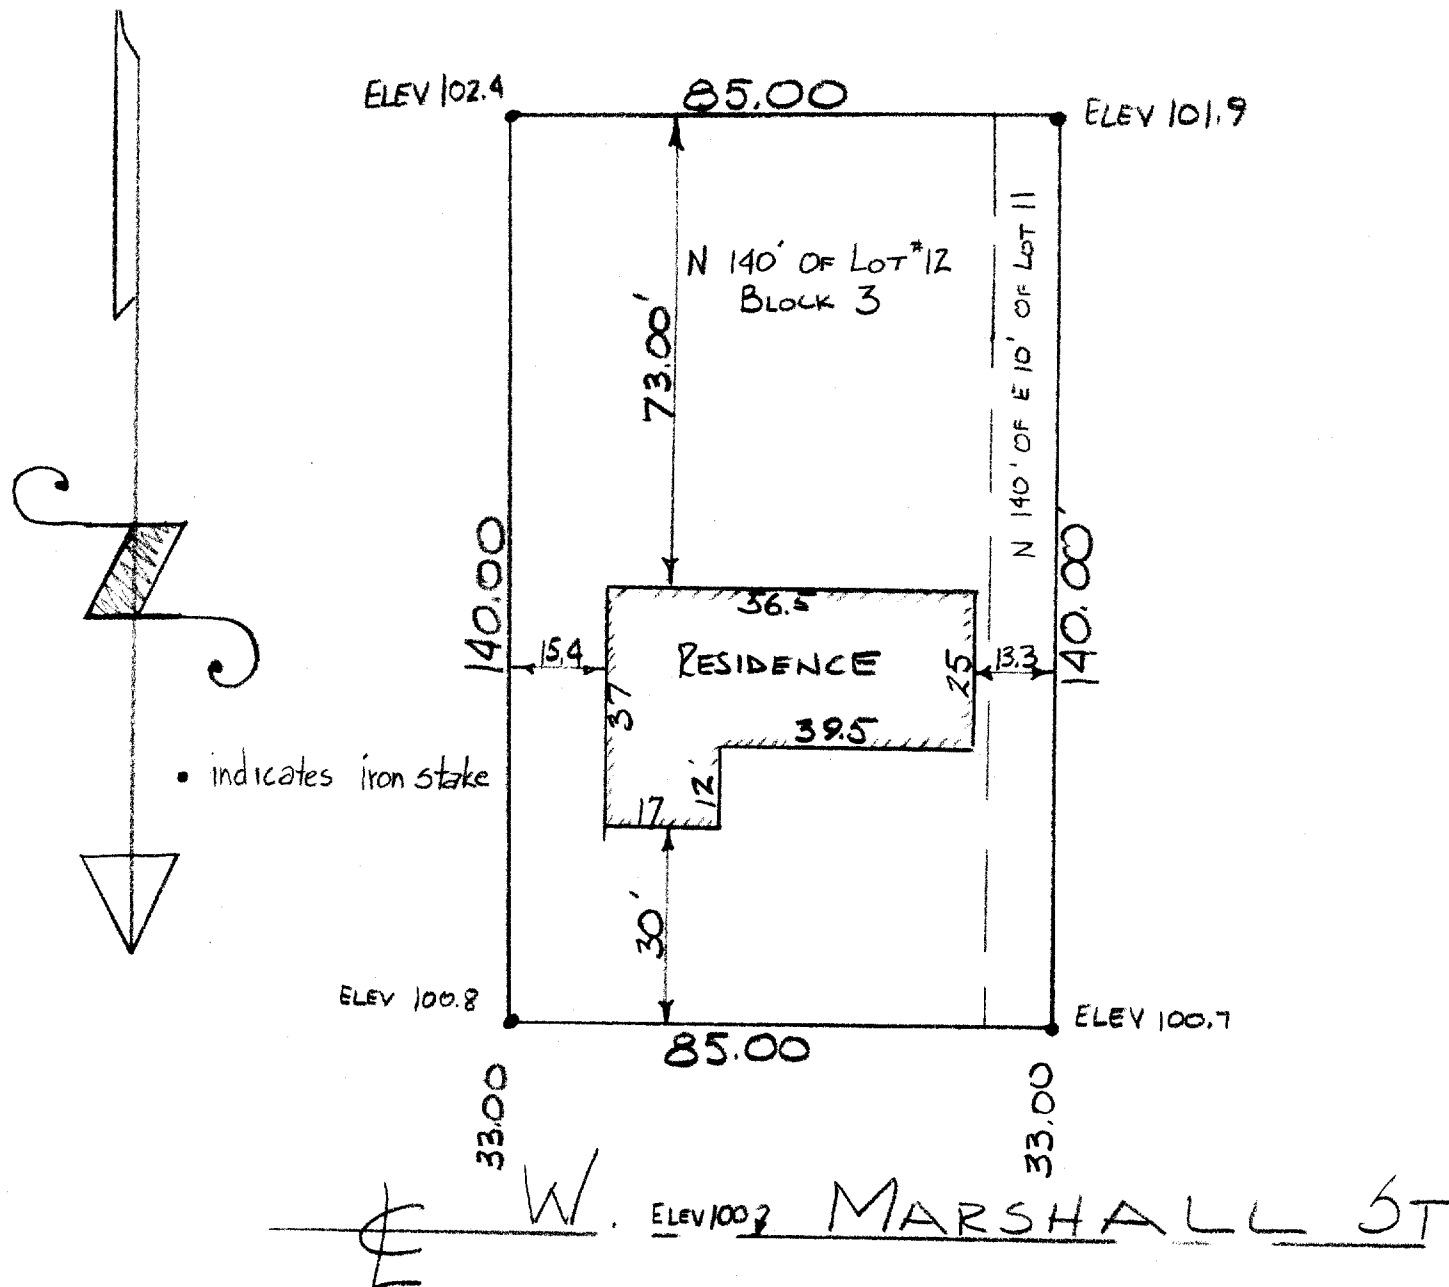

DESCRIPTION: The north 140 feet of lot 12 and the east 10 feet of the north 140 feet of lot 11 block 3, James Jones Second Addition to the City of Elkhorn, Walworth County, Wisconsin.

CERTIFICATE: I, James F. Biagi, surveyor, do hereby certify that I have surveyed the property herein described and that the location of all of the improvements be as shown.

James F. Biagi
James F. Biagi
Surveyor