


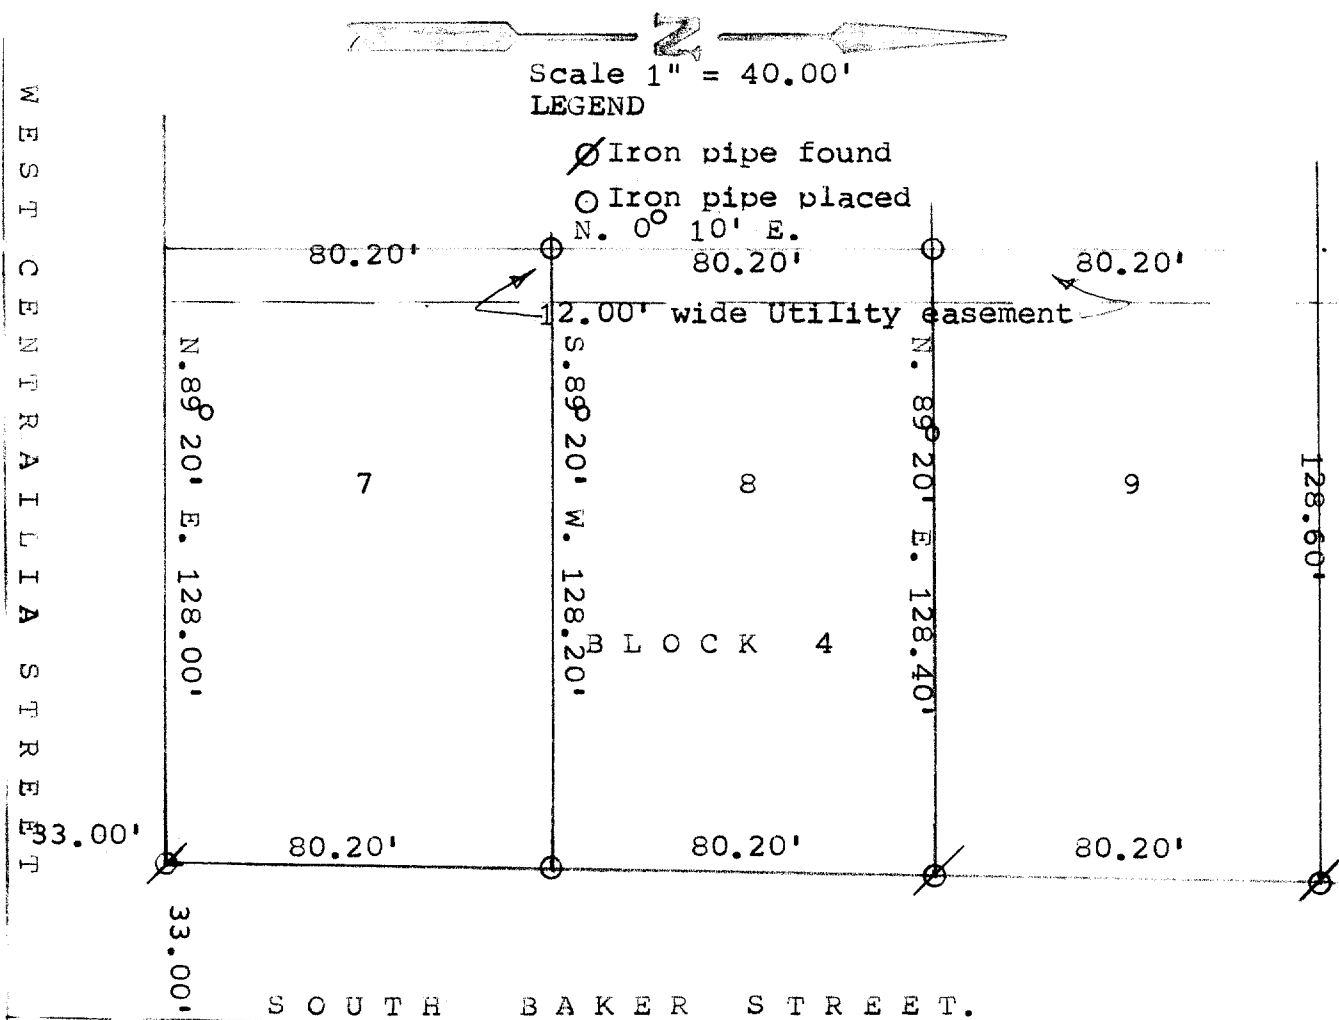

DESCRIPTION: Lot 8 Block 4 James Jones 2nd Addition to the City of Elkhorn, Walworth County, Wisconsin.

CERTIFICATE: I, Joseph M. Biagi, Surveyor do hereby certify that I have surveyed the property hereon portrayed and described.

July 1st 1974.

Joseph M. Biagi RLS #12
Elkhorn, Wisconsin.

