


RECEIVED
FEB 26 1977

LOT 16

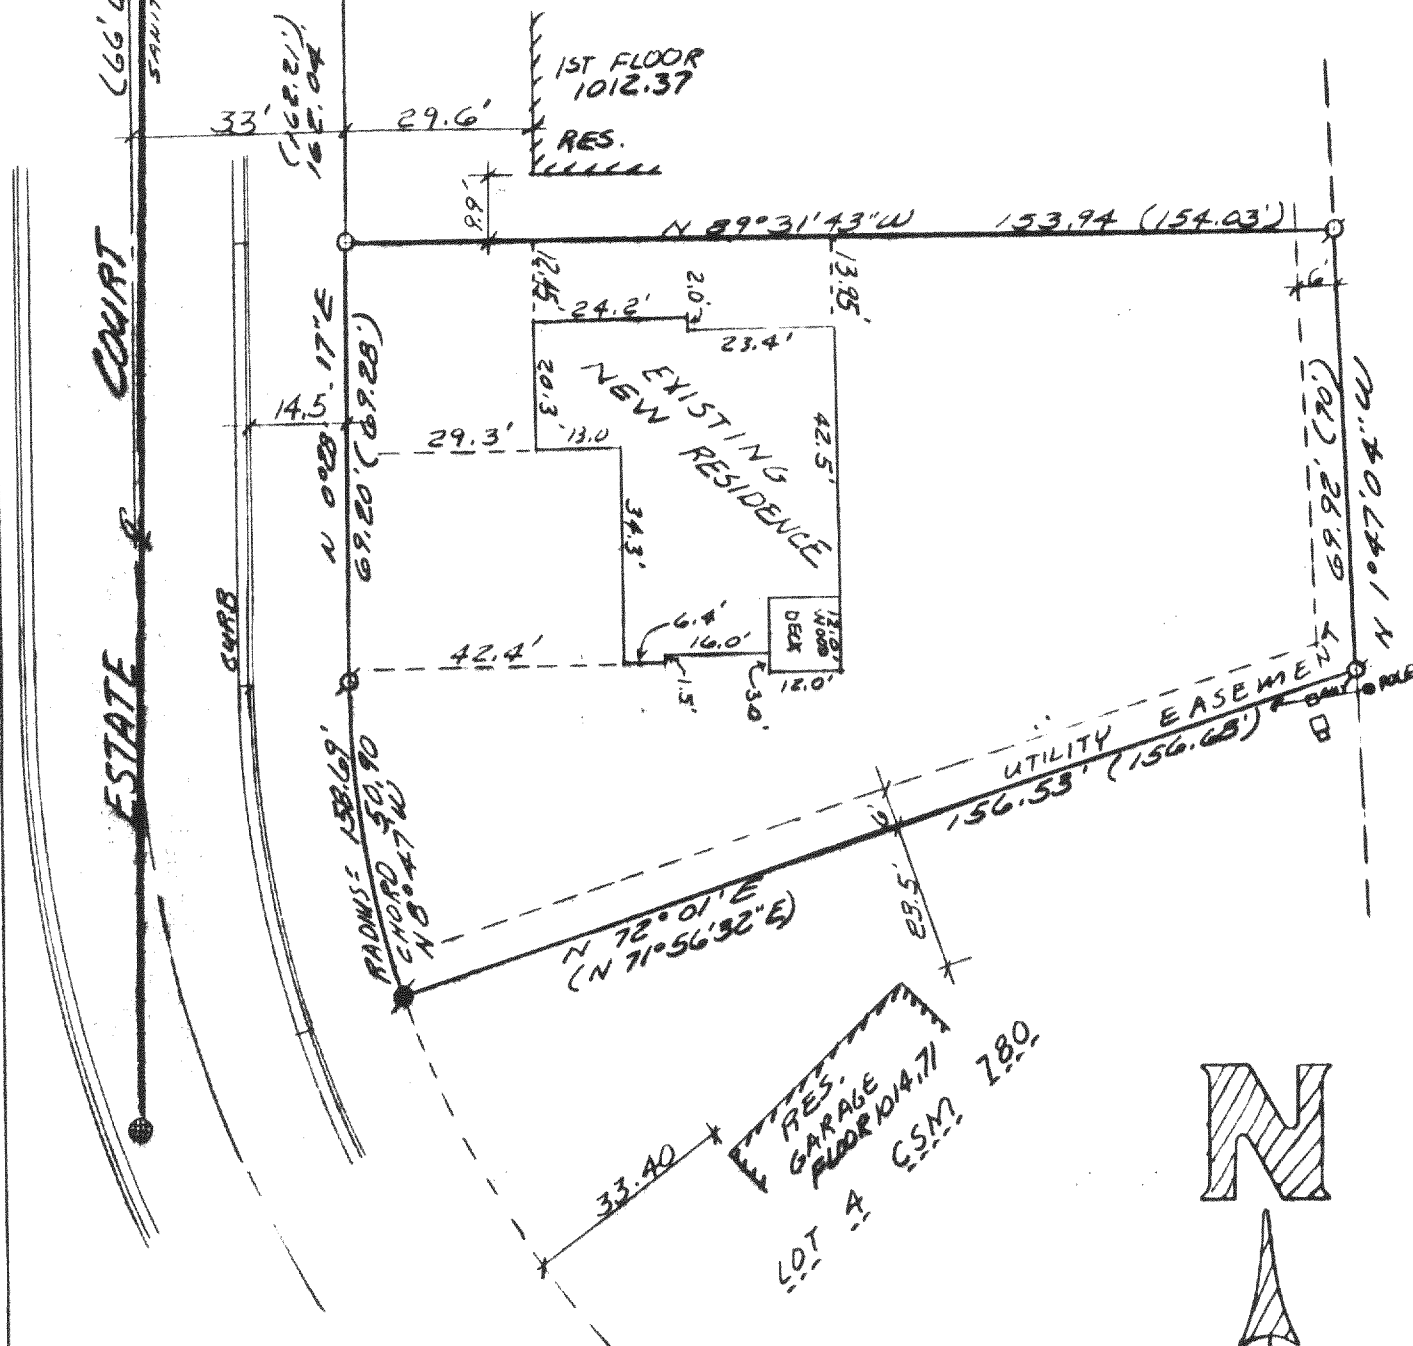

FOR
UNIVERSAL MORTGAGE CORP.

Ø = IRON PIPE FOUND O = PIPE SET
● = IRON BAR FOUND

I hereby certify that I have surveyed the above described property and that the above map is a true representation thereof and shows the size and location of the property, its exterior boundaries, the location of all visible structures and dimensions of all principal buildings thereon, boundary fences, apparent easements, roadways and visible encroachments, if any.

This survey is made for the use of the present owners of the property, and also those who purchase, mortgage, or guarantee the title thereto within one (1) year from the date hereof.

Robert C. Jarvis
11/24/86



PROJECT NO. 2643