


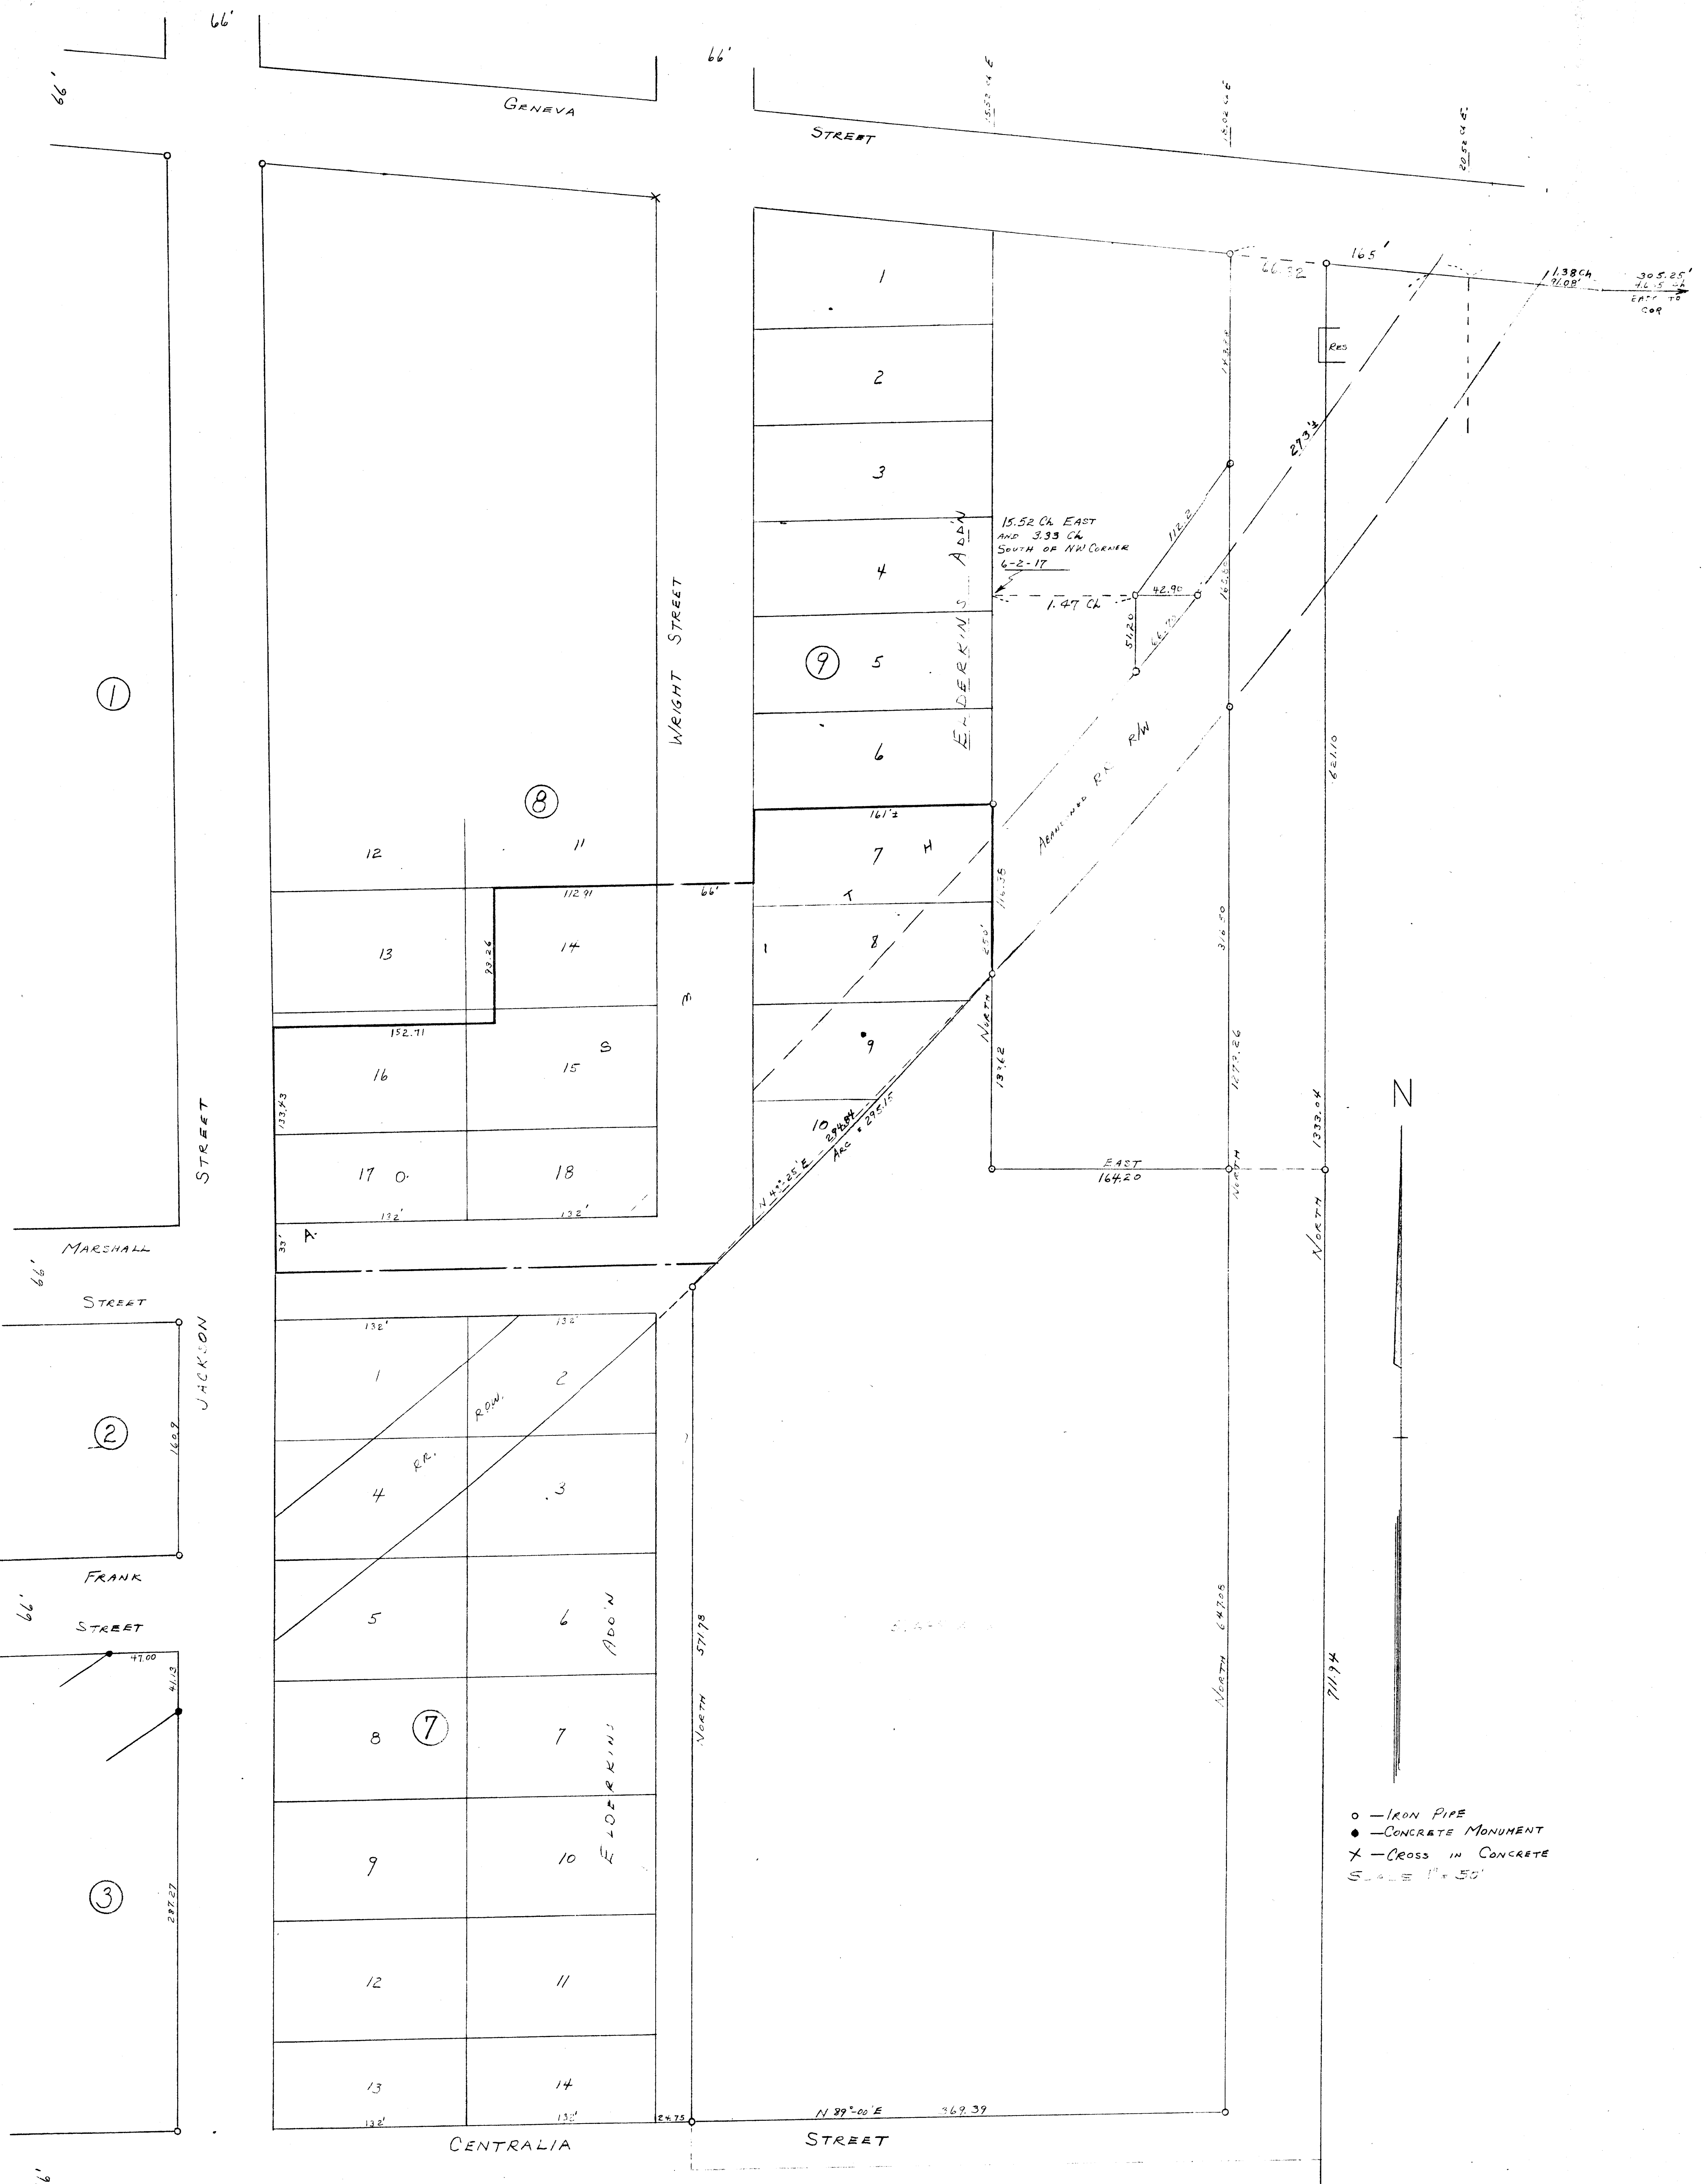

PLAT OF SURVEY OF LAND
IN NW $\frac{1}{4}$ OF SECTION 6, T22N R17E,
CITY OF ELKHORN, WALWORTH
COUNTY, WISCONSIN

Nov 1958

Lloyd Jensen
SURVIVOR

4-4

VSE-18A + Elderkin add.