



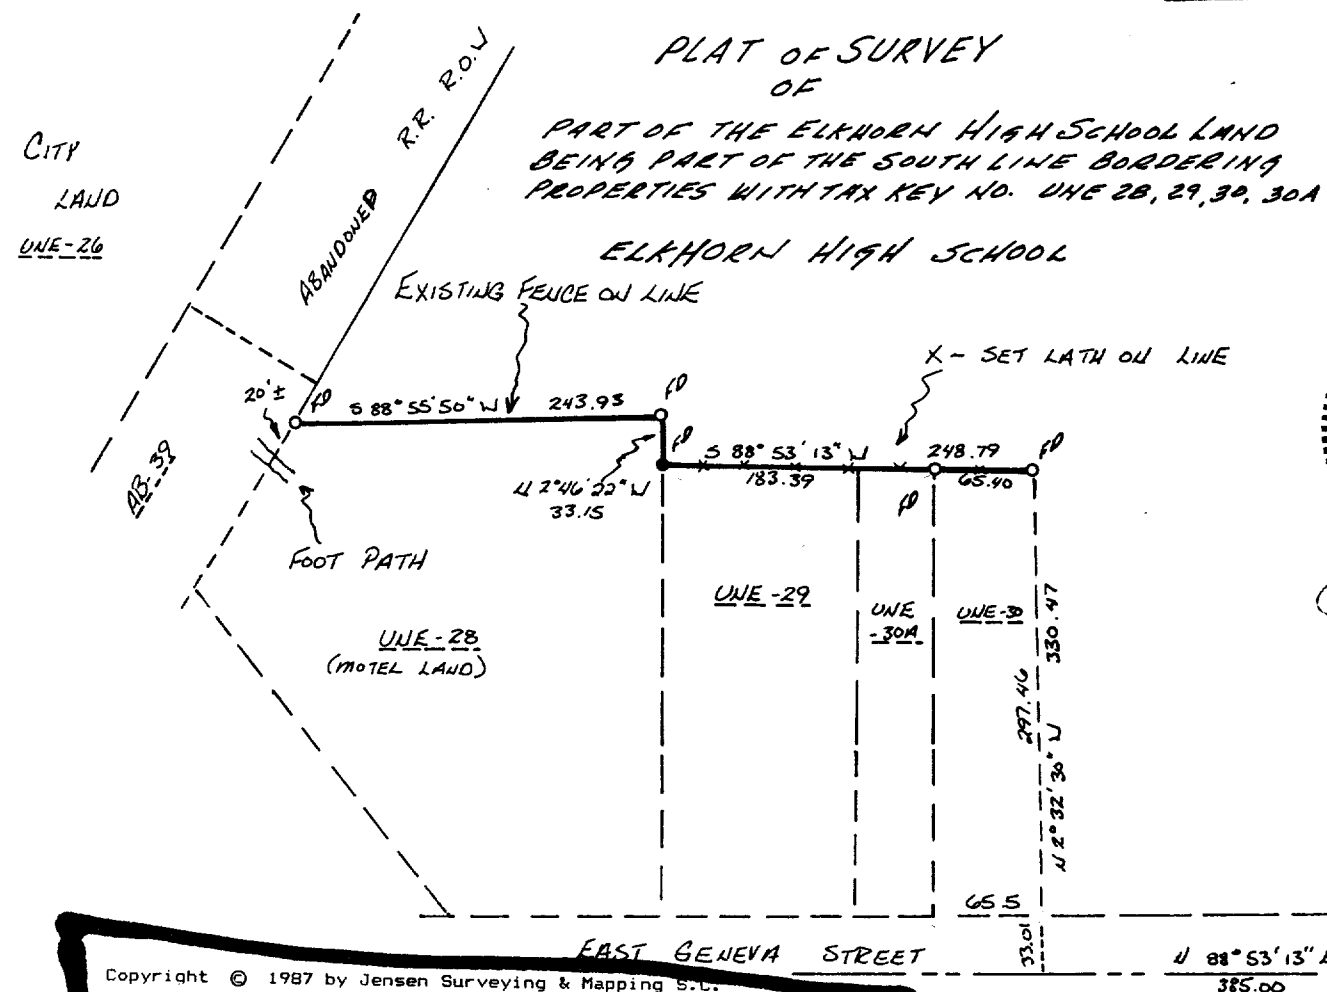

All rights reserved. No part of this survey plat may be reproduced or transmitted in any form by any means - graphic, electronic, or mechanical, including photocopying, tracing, or information storage and retrieval systems - without permission in writing from Thomas P.A. Jensen, Jensen Surveying & Mapping S.C.

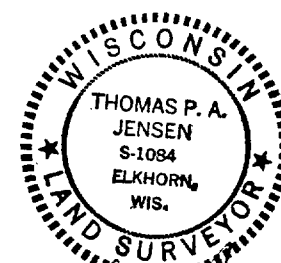

11-28-86

NENSEN SURVEYING & MAPPING, S.C.
ELKHORN, 6/15. 723-3434

SCALE 1" = 100'

FD- FOUND IRON ROD
OR IRON PIPE

SOUTH 1/4
SEC. 31-3-17

1986.142

Do NOT photocopy

South line of YUNE-28A
 North line of YUNE. 28, 29, 30, 30A.

4-451