

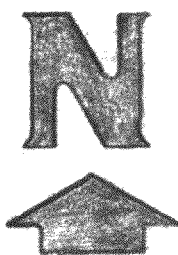


PLAT OF SURVEY OF  
LOT 5 OF WEST OAK PARK, A SUBDIVISION LOCATED IN THE  
CITY OF ELKHORN, WALWORTH COUNTY, WISCONSIN  
FOR GARY PRAEFKE

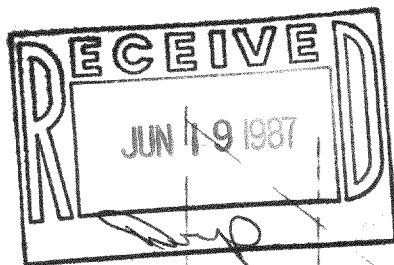


BENCH MARK →  
S. BOLT UPPER FLANGE  
HYDRANT NW COR. INT.  
OAK & EDGEWOOD  
EL 1011.44 FROM  
CITY RECORDS

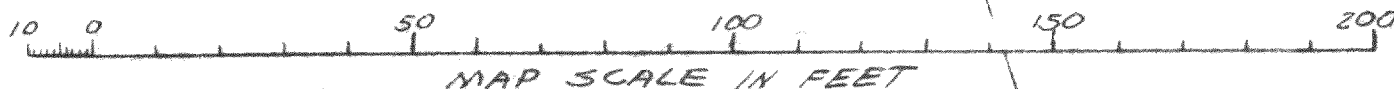

ELEVATION OF INSTALLED  
SANI LATERAL NOT  
AVAILABLE - VERIFY  
BASEMENT SERVICE  
POSSIBLE TO LATERAL  
AS SWILT BEFORE  
FIXING HOUSE ELEVATION

LOT 4

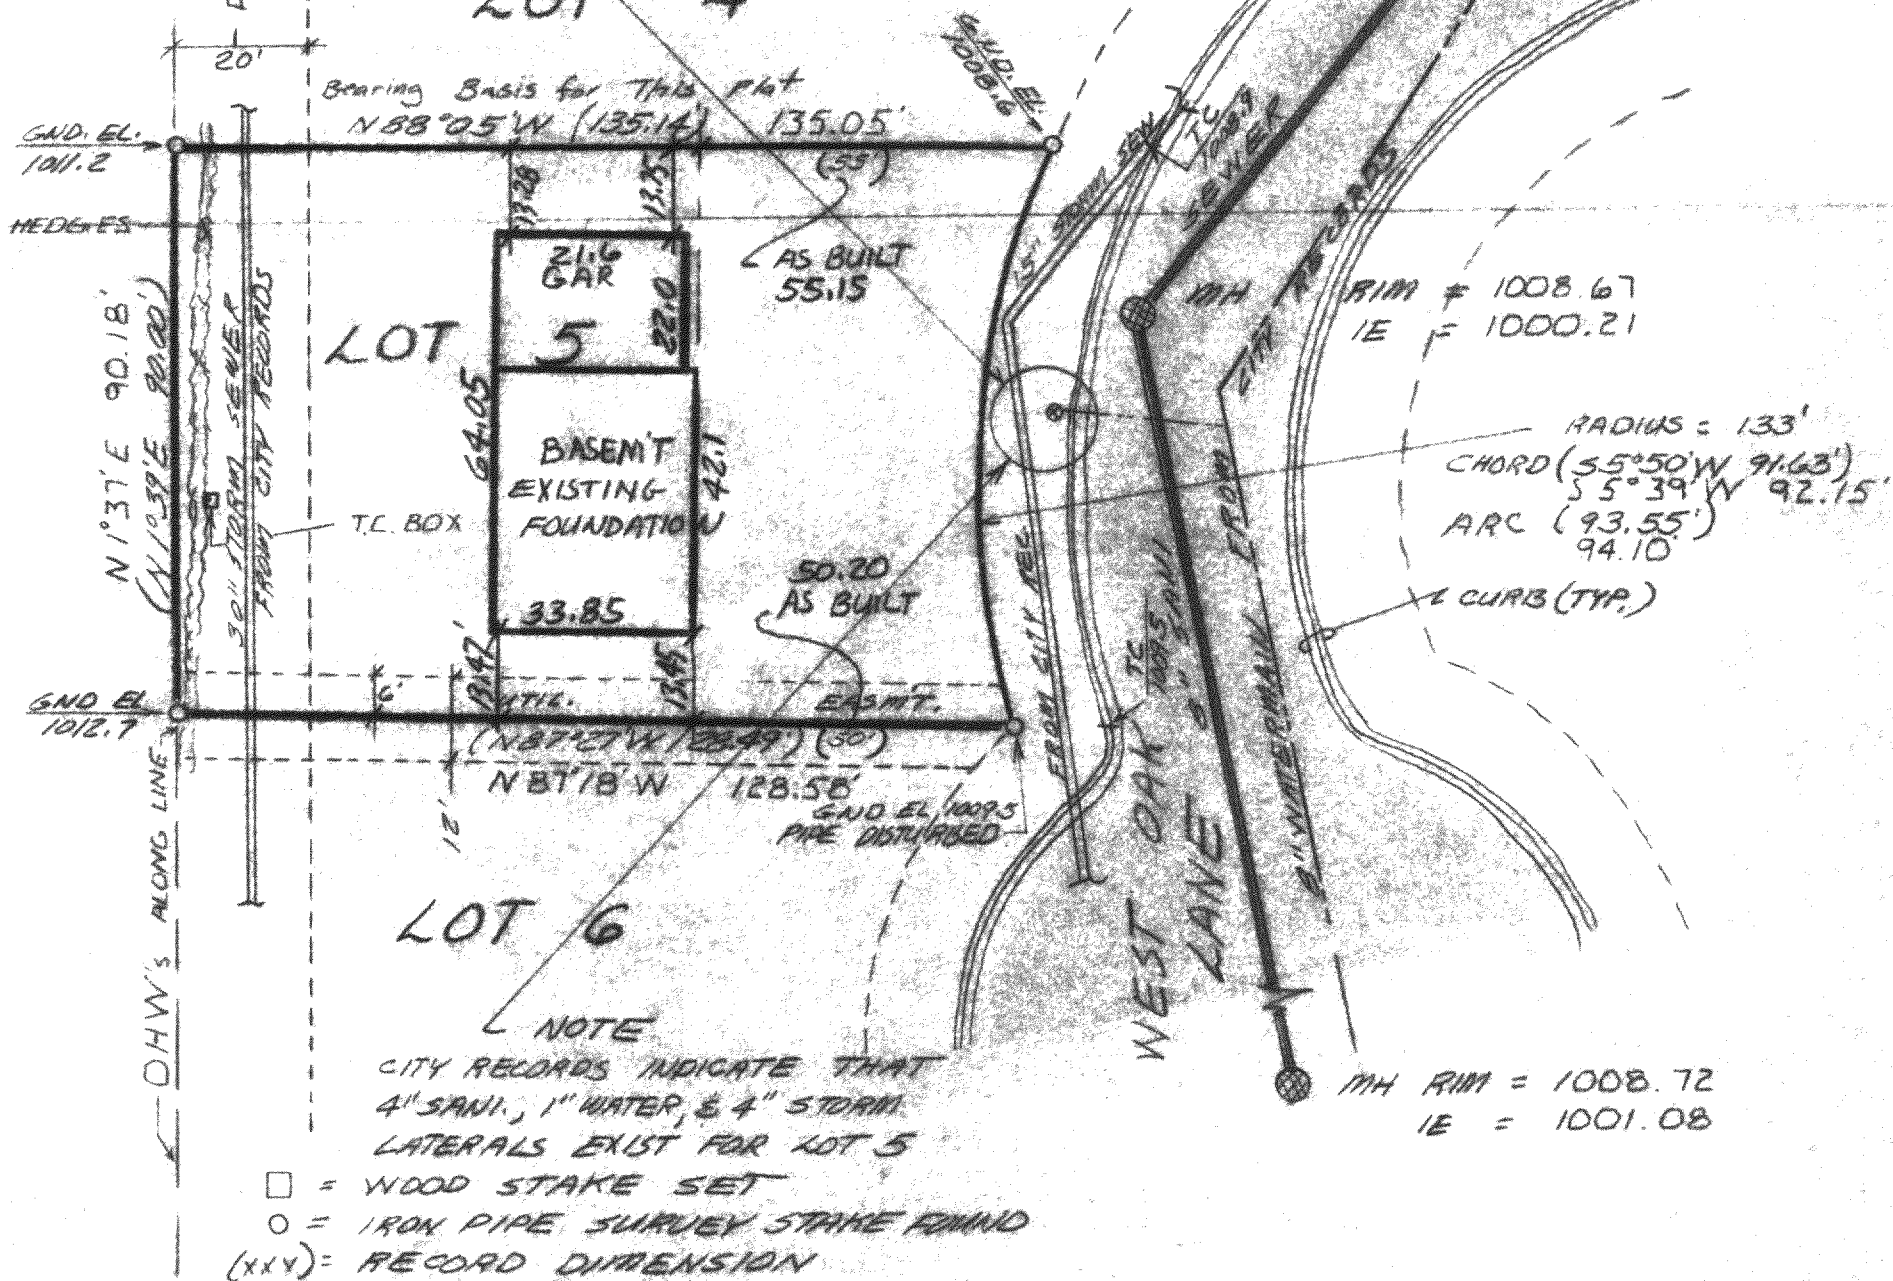

I hereby certify that I have surveyed the above described property and that the above map is a true representation thereof and shows the size and location of the property, its exterior boundaries, the location of all visible structures and dimensions of all principal buildings thereon, boundary fences, apparent easements, roadways and visible encroachments, if any.

This survey is made for the use of the present owners of the property, and also those who purchase, mortgage, or guarantee the title thereto within one (1) year from the date hereof.

Dated this 13<sup>th</sup> day of APRIL 1987  
PROJECT NO. 2738

Robert H. Davis

4-456