

FARRIS, HANSEN & ASSOCIATES, INC.

7 RIDGEWAY COURT, P.O. BOX 487, ELKHORN, WISCONSIN

TEL. 414-723-2098

LOCATION: LOT 10 OF NICHOLS SUBDIVISION NW SEC 31
CITY OF ELKHORN, WALWORTH COUNTY, WI



WORK ORDERED BY: ERSKINE CONSTRUCTION



MAP SCALE IN FEET

MAP LEGEND

- = IRON PIPE STAKE FOUND
- = IRON PIPE STAKE SET
- = IRON ROD STAKE FOUND
- = IRON ROD STAKE SET
- = CONCRETE MONUMENT FOUND
- (XXXXX) = RECORD DIMENSION

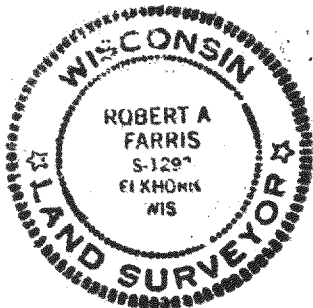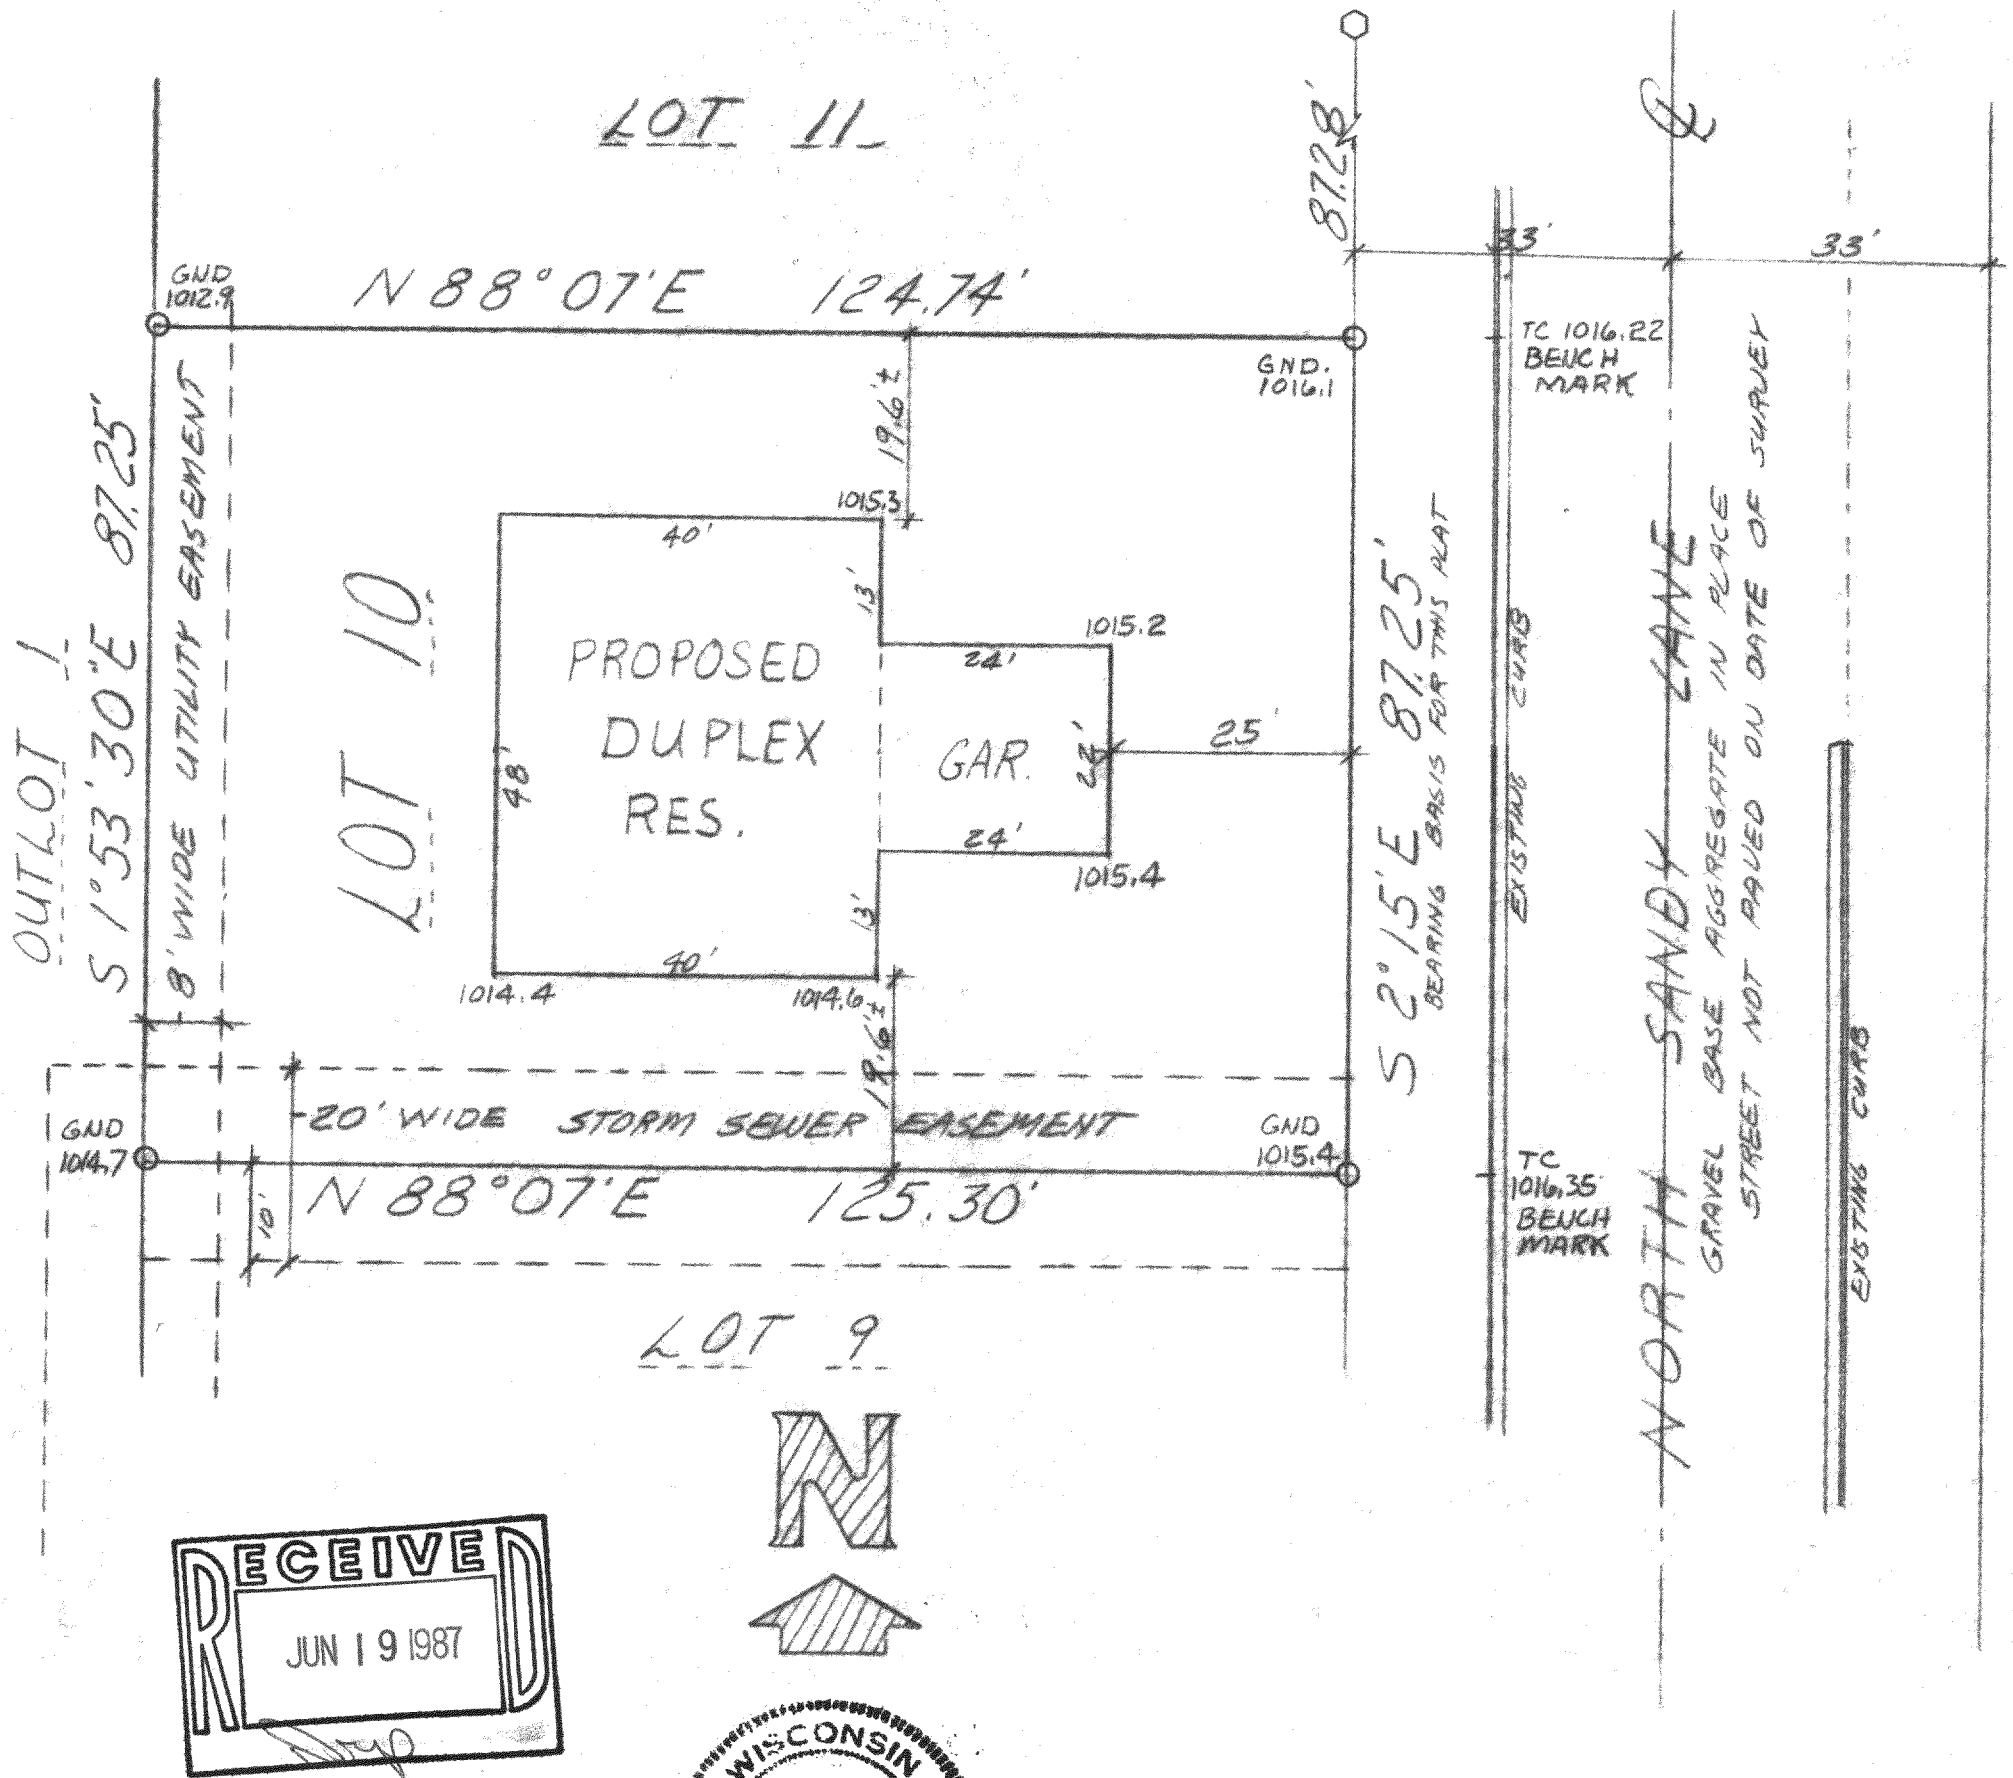

I hereby certify that the above described property has been surveyed under my direction and that the above map is a true representation thereof and shows the size and location of the property, its exterior boundaries, the location of all visible structures and dimensions of all principal buildings thereon, boundary fences, apparent easements, roadways and visible encroachments, if any. This survey is made for the use of the present owners of the property, and also those who purchase, mortgage, or guarantee the title thereto within one year from the date hereof.

DATED : JUNE 19, 1987

Robert A. Farris

PROJ. NO. 2828-10

TEL. 414-723-2098

REPRODUCED BELOW IS AS BUILT UTILITY DATA AVAILABLE FOR PART OF NORTH SANDY LANE



Robert A. Harris

PROJ. NO. 2828
STREET UTILITY DATA