
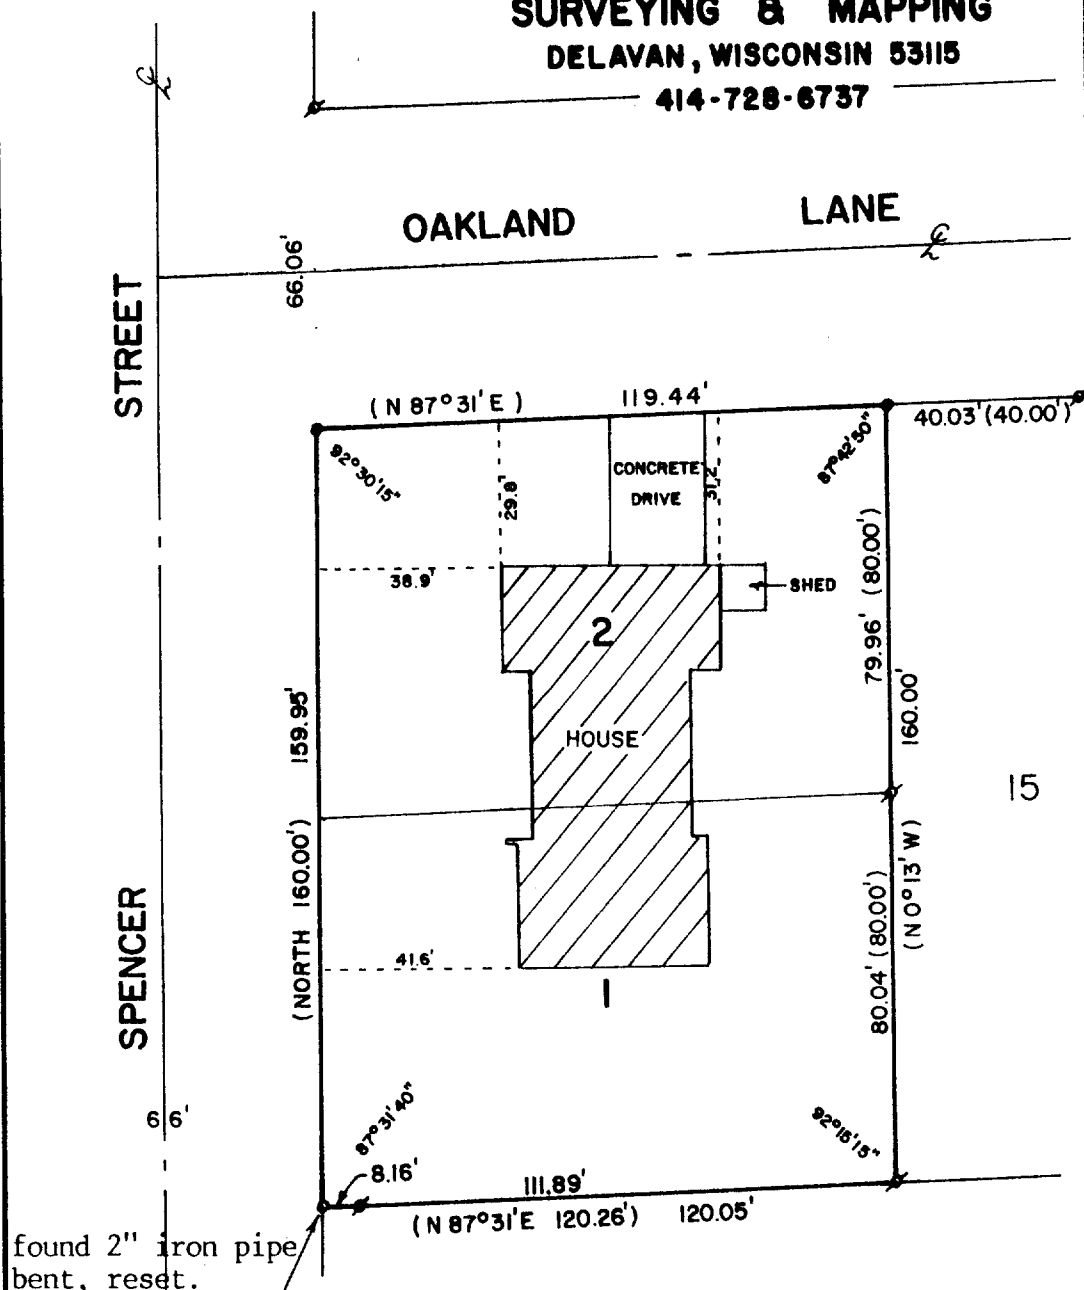


ABELL
SURVEYING & MAPPING
 DELAVAN, WISCONSIN 53115
 414-728-6737

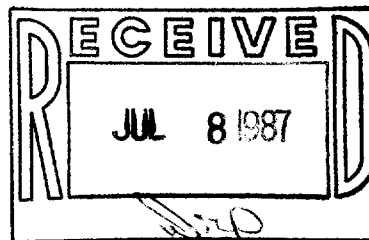

PLAT OF SURVEY OF

LOTS 1 AND 2 OF OAKLAND SUBDIVISION, CITY
 OF ELKHORN, WALWORTH COUNTY, WISCONSIN.

ORDERED BY: ERA LANHAM REALTY
 20 S. WASHINGTON ST.
 ELKHORN, WI 53121



SCALE - 1"=40'

LEGEND

- ⊗ - IRON PIPE FOUND
- ⬢ - CONCRETE MONUMENT FOUND
- - IRON PIPE SET
- () - RECORDED AS

I, DAVID F. ABELL, DO HEREBY CERTIFY
 THAT I HAVE SURVEYED THE PROPERTY
 HEREON DESCRIBED ACCORDING TO THE
 OFFICIAL RECORDS AND THAT THE PLAT
 HEREON IS A CORRECT REPRESENTATION
 OF THE PROPERTY LINES TO THE BEST OF
 MY KNOWLEDGE AND BELIEF.

David F. Abell

DAVID F. ABELL
 WISCONSIN REGISTERED LAND SURVEYOR, S-1596

DATE June 16, 1987

JOB NUMBER - 87076

NOTE: THIS IS NOT A CERTIFIED COPY UNLESS SEALED.