


D.D. COOPER & CO. INC.

ROUTE 4, BOX 501 B
ELKHORN, WI 53121

PH 414-723-6265

SURVEYING • MODULAR HOMES

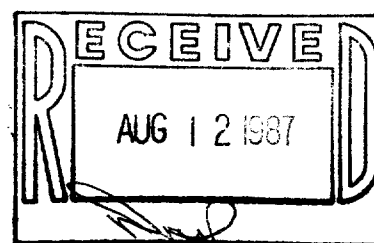



PLAT OF SURVEY OF LOT 5 BLOCK 46
DAVIS ADDITION TO THE CITY OF
ELKHORN WALNORTH COUNTY WISCONSIN

SURVEY ORDERED BY
KENDSHA SAVINGS & LOAN
LAKE GENEVA WI

I, DANIEL D. COOPER, REGISTERED SURVEYOR, DO HEREBY CERTIFY THAT
I HAVE SURVEYED THE PROPERTY DESCRIBED HEREON AND THAT THE MAP
SHOWN HEREON IS A TRUE AND ACCURATE REPRESENTATION THEREOF TO THE
BEST OF MY PROFESSIONAL KNOWLEDGE AND BELIEF.

DATED THIS DAY OF .1984

DANIEL D. COOPER, RLS NO. 5-1464

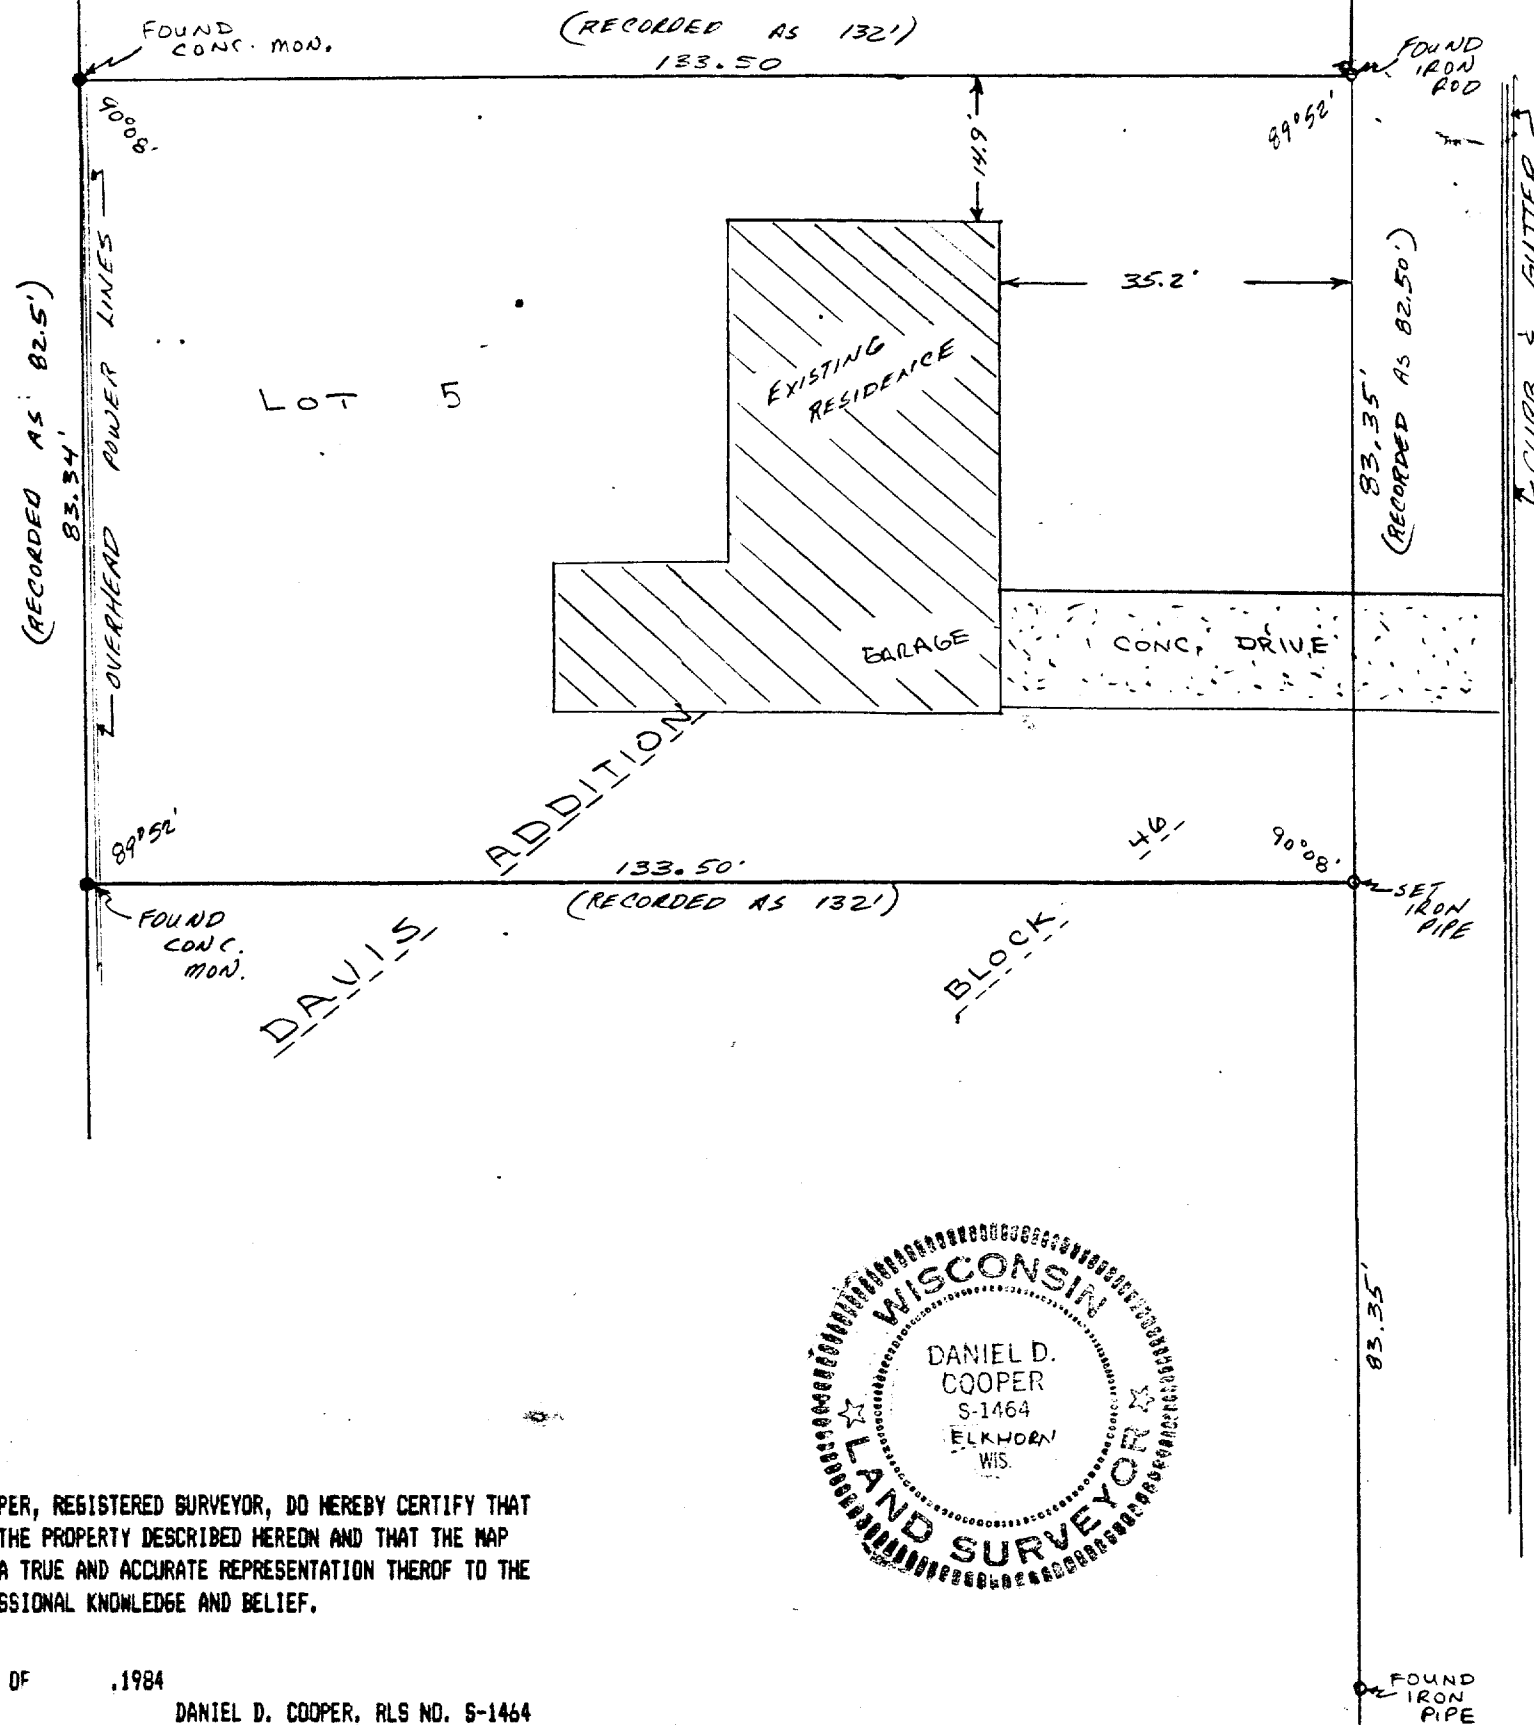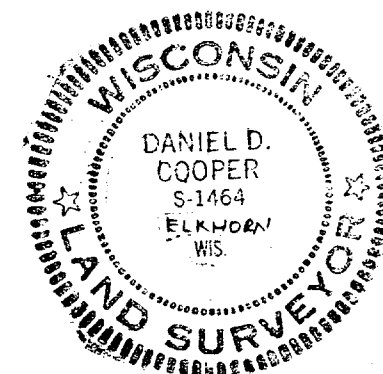

SCALE 1" = 20'

DRAWING 2054-1-39

4-465