

D.D. COOPER & CO. INC.


ROUTE 1, BOX 101 B
ELKHORN, WI 53121

PH 414-723-6265

SURVEYING • MODULAR HOMES


PLAT OF SURVEY OF LOT 7 BLOCK 4 OF FAIRLANE SUBDIVISION
ADDITION NO 1 LOCATED IN THE NW 1/4 OF SECTION 31
T3N R17E CITY OF ELKHORN WALWORTH COUNTY WISCONSIN

SURVEY ORDERED BY
MARINE BANK SOUTHWEST-ELKHORN

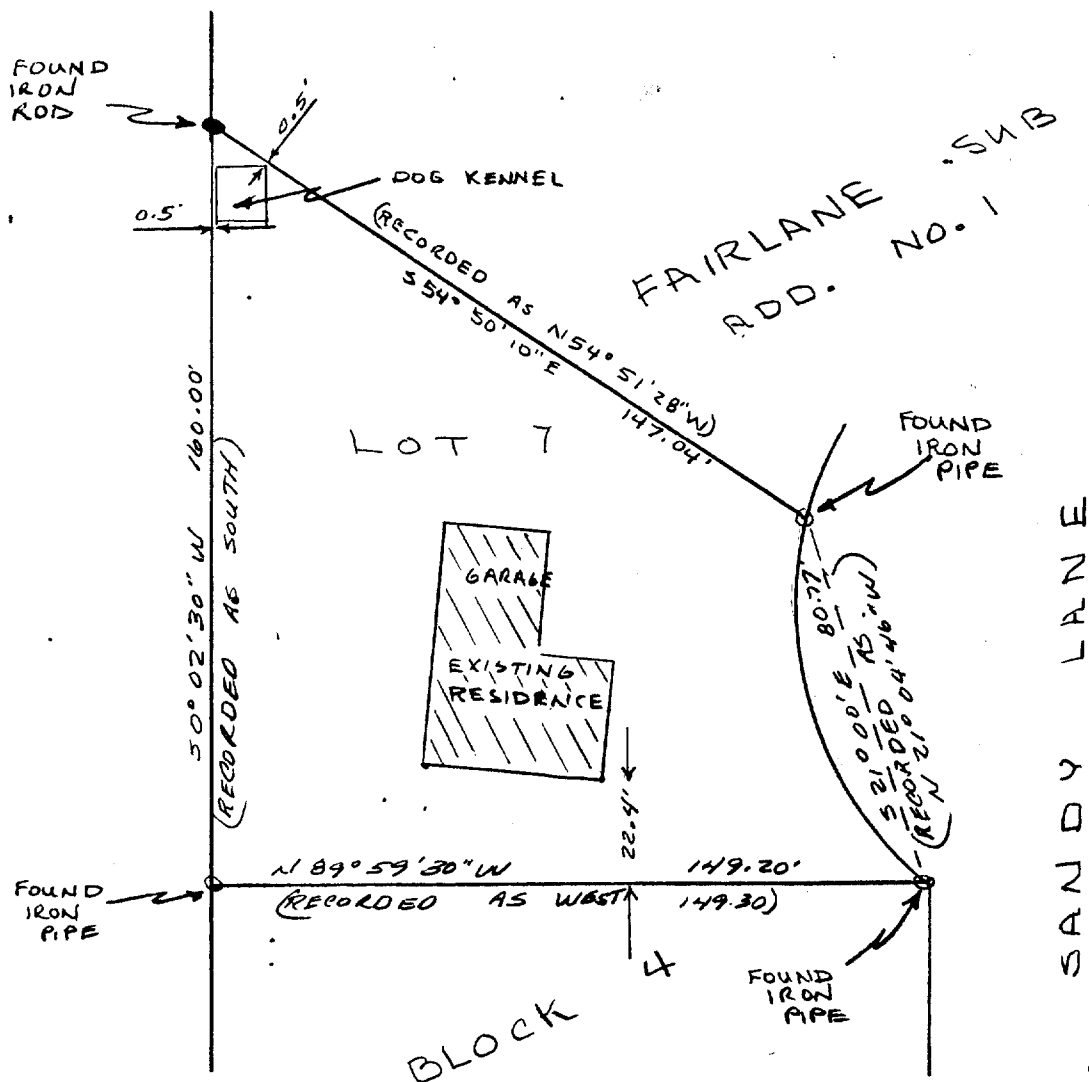

I, DANIEL D. COOPER, REGISTERED SURVEYOR, DO HEREBY CERTIFY THAT
I HAVE SURVEYED THE PROPERTY DESCRIBED HEREON AND THAT THE MAP
SHOWN HEREON IS A TRUE AND ACCURATE REPRESENTATION THEREOF TO THE
BEST OF MY PROFESSIONAL KNOWLEDGE AND BELIEF.

DATED THIS 22 DAY OF JULY, 1985 *Daniel D. Cooper*
DANIEL D. COOPER, RLS NO. S-1464

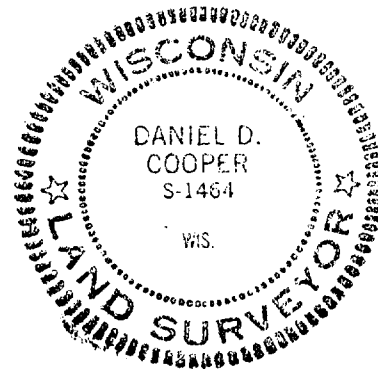

DRAWING NO 2062

4466