


D.D. COOPER & CO. INC.

ROUTE 4, BOX 501 B
ELKHORN, WI 53121

PH 414-723-6265


SURVEYING • MODULAR HOMES

PLAT OF SURVEY OF PROPERTY LOCATED IN THE
CITY OF ELKHORN WALWORTH COUNTY WISCONSIN
MORE PARTICULARLY DESCRIBED AS FOLLOWS
BEGINNING ON THE NORTH LINE OF COURT STREET
82.5 FEET EAST OF THE EAST LINE OF OLSEN STREET
THENCE EAST 66.60 FEET; THENCE NORTH 132 FEET;
THENCE WEST 66.60 FEET; THENCE SOUTH 132 FEET
TO THE POINT OF BEGINNING

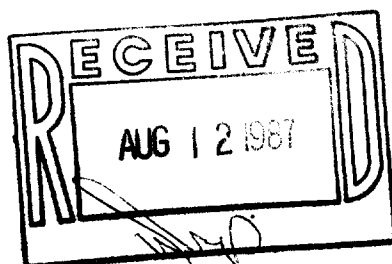

BEARING REFERENCE
NORTH LINE OF COURT STREET ASSUMED
TO BEAR EAST-WEST

SCALE 1"=20'

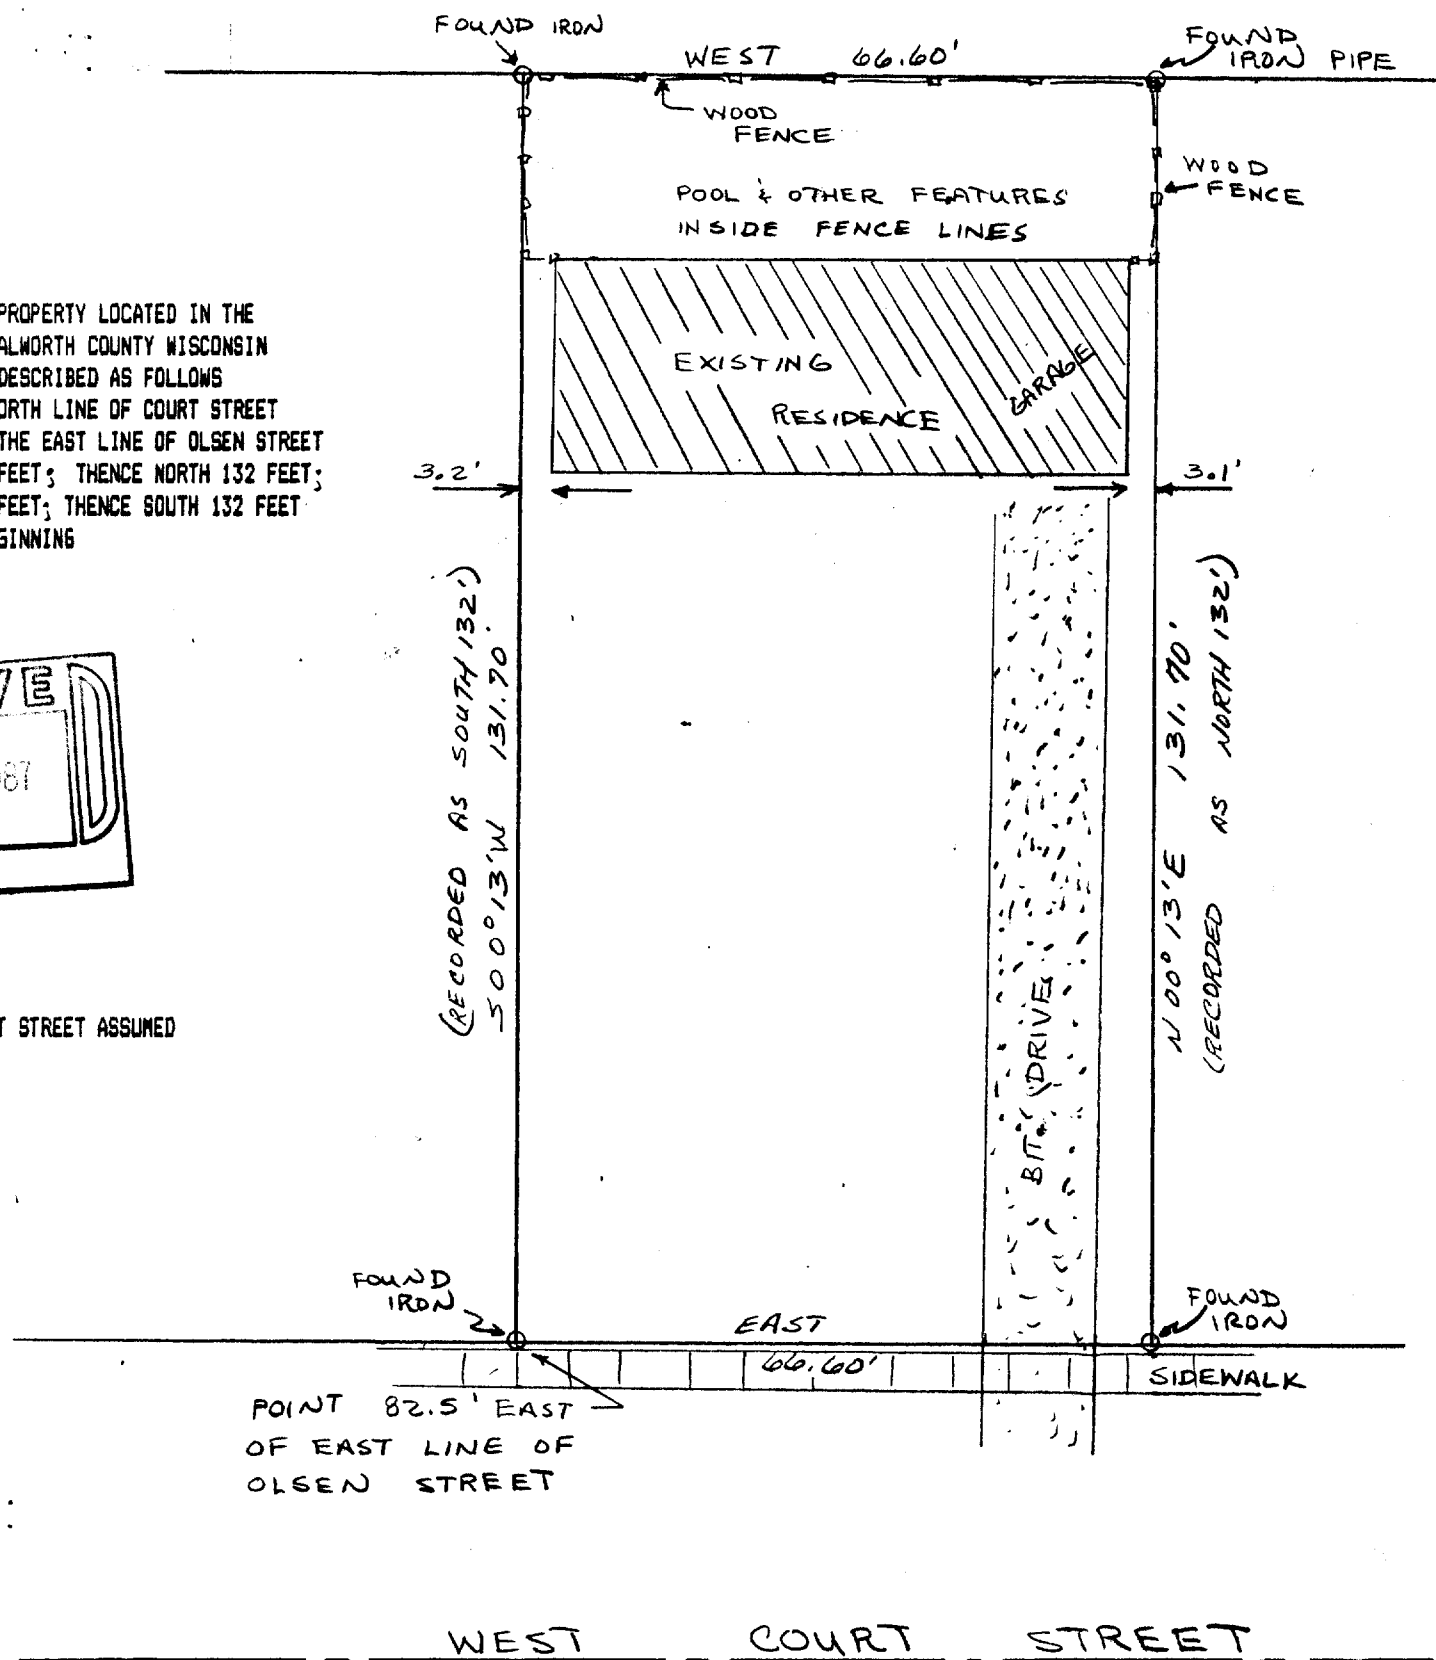

I, DANIEL D. COOPER, REGISTERED SURVEYOR, DO HEREBY CERTIFY THAT
I HAVE SURVEYED THE PROPERTY DESCRIBED HEREON AND THAT THE MAP
SHOWN HEREON IS A TRUE AND ACCURATE REPRESENTATION THEROF TO THE
BEST OF MY PROFESSIONAL KNOWLEDGE AND BELIEF.

DATED THIS 10 DAY OF FEB. 1986

Daniel D Cooper
DANIEL D. COOPER, RLS NO. S-1464



DRAWING NO. 2114-

Yunbw-117

4-469