


61-57


4-478

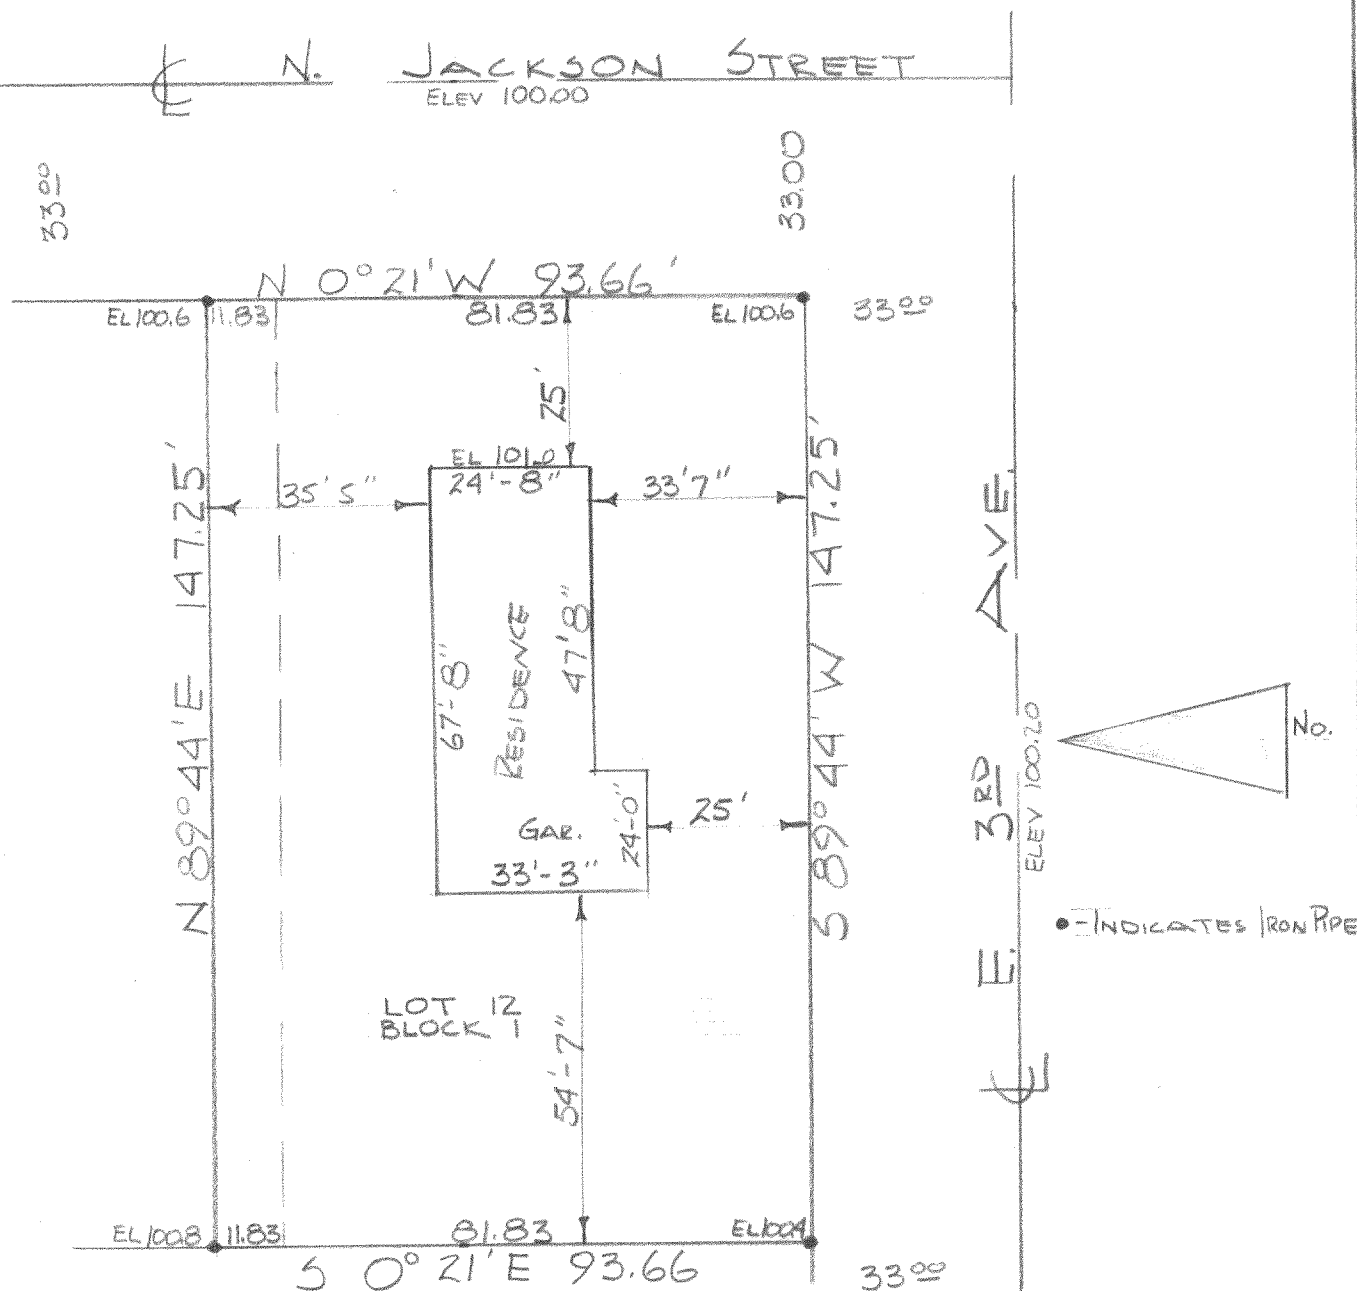

DESCRIPTION: Lot 12 and the South 11.83 feet of Lot 11 of Block 1 of Tree Towns Subdivision in the City of Elkhorn, Walworth County, Wisconsin.

CERTIFICATE: I, James F. Biagi, surveyor, do hereby certify that I have surveyed the property hereon described and that the location of the improvements as shown on the above drawing.

July 1961

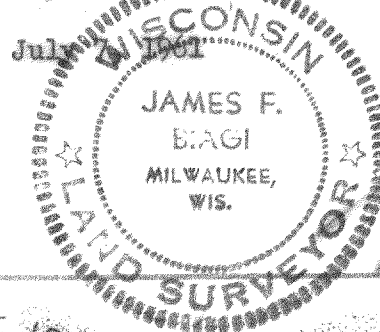

James F. Biagi RLS 272

YTTS-12

4-478