

of Lot 1, Block 1, Ridgway - Martin Addition to the city of
Elkhorn, Walworth County, Wisconsin

SURVEYED FOR: Lyons Mortgage
933 N. Mayfair Rd.
Milwaukee, WI 53226

SURVEYED FOR: Lyons Mortgage
933 N. Mayfair Rd.
Milwaukee, WI 53226


SURVEYED BY: Jensen Surveying & Mapping S.C.
45 S. Wisconsin St. P.O. Box 322
Elkhorn, Wisconsin. 53121
(414) 723-3434

Copyright © 1987 by Jensen Surveying & Mapping S.C.
All rights reserved.

All rights reserved. No part of this survey plat may be reproduced or transmitted in any form by any means - electronic, or mechanical, including photocopying, graphic, information storage and retrieval systems - without permission in writing from Thomas P.A. Jensen, Jensen Surveying & Mapping S.C.

I, Thomas P.A. Jensen, Wisconsin Registered Land Surveyor, do hereby certify that this survey was performed by me, or under my direction, in full compliance with the owner's/agent's instructions and Chapter A-E 5 of the Wisconsin Administrative Code "Minimum Standards For Property Surveys"; and that this map is an accurate representation thereof to the best of my knowledge and belief.

Thomas P.A. Jensen R.L.S-1084
Jensen Surveying & Mapping S.C.

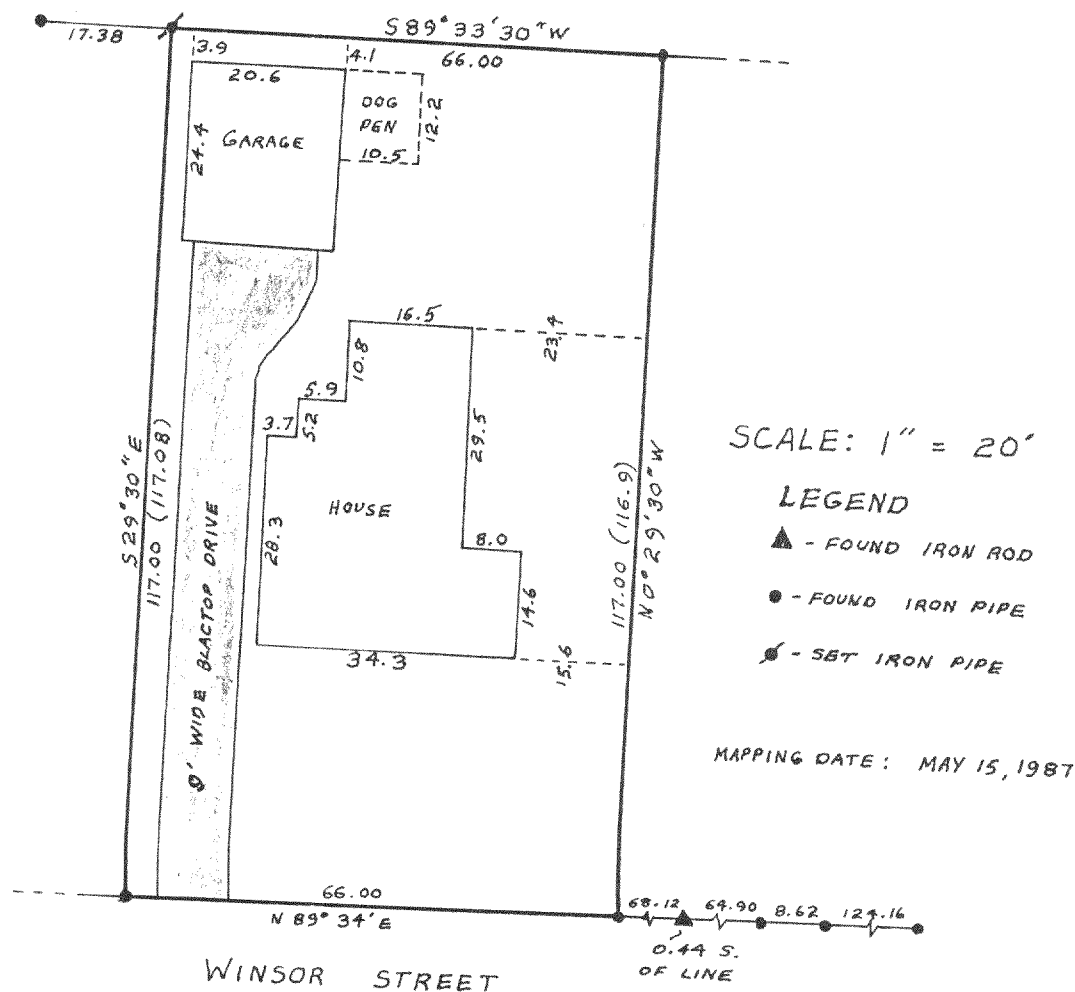

Note: This survey plat is not certified unless signed and sealed in red ink.

1987.048 X

4-487