
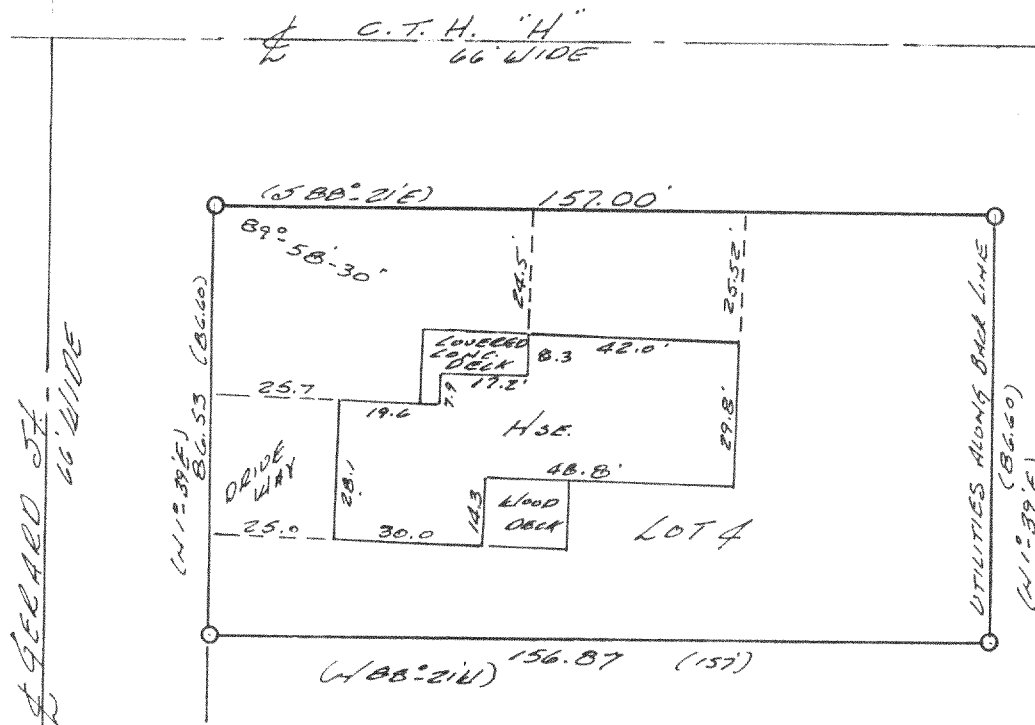


PLAT OF SURVEY OF LOT 4  
CERTIFIED SURVEY NO. 65  
LOCATED IN THE NE $\frac{1}{4}$  OF  
SEC. 36, T3N R16E, CITY OF  
ELKHORN, WIS. CO. 6/15.

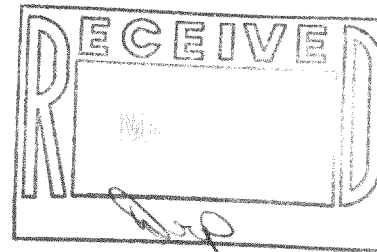

Copyright © 1987 by Jensen Surveying & Mapping S.C.

All rights reserved. No part of this survey plat may be reproduced or transmitted in any form by any means - graphic, electronic, or mechanical, including photocopying, tracing, or information storage and retrieval systems - without permission in writing from Thomas P.A. Jensen, Jensen Surveying & Mapping S.C.

SURVEYED FOR:

RANDY LEECE  
ELKHORN, WIS.

SCALE 1" = 30'

○ - IRON PIPE FOUND

Note: This survey plat is not certified unless signed and sealed in red ink.

I, Thomas P.A. Jensen, Wisconsin Registered Land Surveyor, do hereby certify that this survey was performed by me, or under my direction, in full compliance with the owner's/agent's instructions and Chapter A-E 5 of the Wisconsin Administrative Code "Minimum Standards For Property Surveys"; and that this map is an accurate representation thereof to the best of my knowledge and belief.

Thomas P.A. Jensen R.L.S-1084  
Jensen Surveying & Mapping S.C.

MAPPING DATE: 2/JUNE 19, 1987

1987.065

4-488