


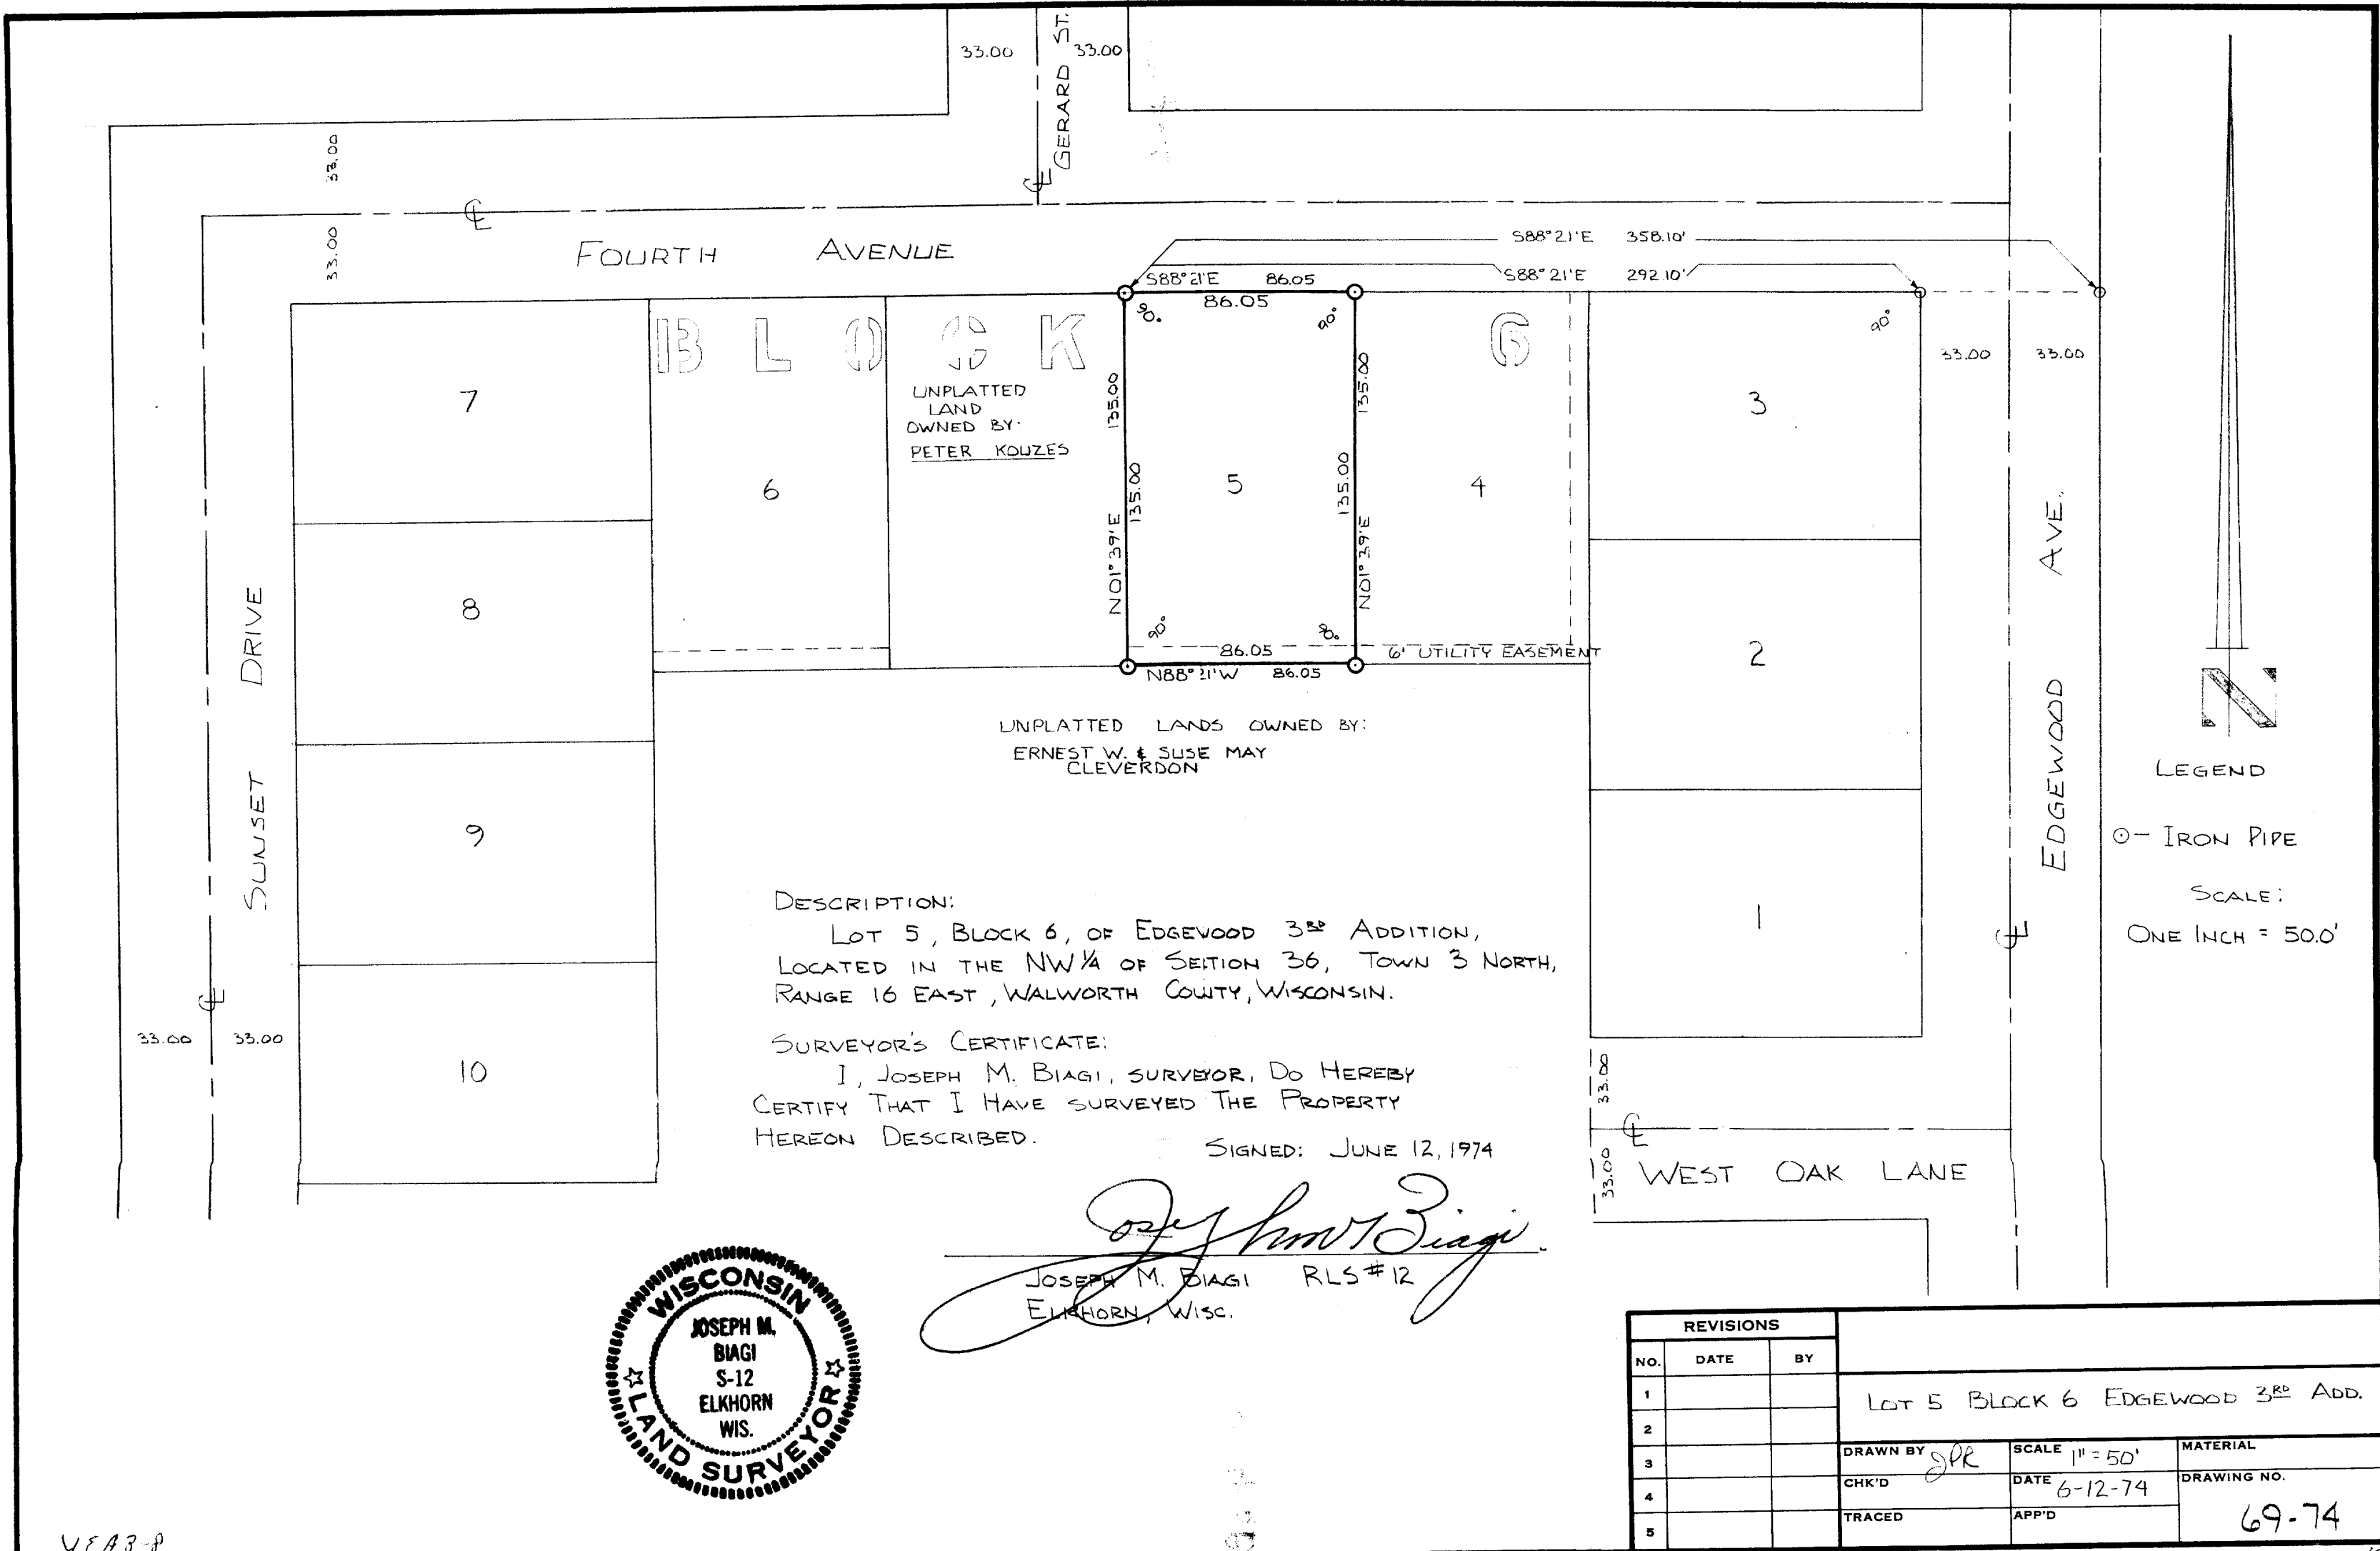

DESCRIPTION:
LOT 5, BLOCK 6, OF EDGEWOOD 3RD ADDITION,
LOCATED IN THE NW 1/4 OF SECTION 36, TOWN 3 NORTH,
RANGE 16 EAST, WALWORTH COUNTY, WISCONSIN.

SURVEYOR'S CERTIFICATE:
I, JOSEPH M. BIAGI, SURVEYOR, DO HEREBY
CERTIFY THAT I HAVE SURVEYED THE PROPERTY
HEREON DESCRIBED.
SIGNED: JUNE 12, 1974



Joseph M. Biagi
JOSEPH M. BIAGI RLS #12
ELKHORN, WISC.

REVISIONS					
NO.	DATE	BY			
1			LOT 5 BLOCK 6 EDGEWOOD 3 RD ADD.		
2					
3					
4					
5					
			DRAWN BY <i>JPR</i>	SCALE 1" = 50'	MATERIAL
			CHK'D	DATE 6-12-74	DRAWING NO.
			TRACED	APP'D	69-74