

BUILDING PERMIT SURVEY

-of-

4. The land referred to in this Commitment is located in the County of Walworth
State of Wisconsin and described as follows:

The South 43 feet of Lot 6, Block 1; and Lot 7, except the South 19 feet, in Rockwell Brothers Addition to the City of Elkhorn, Walworth County, Wisconsin.

(Tax Key No. YRW 3 00002B)

SURVEYED FOR: JOHN GRIEBEL
254 WEST ROCKWELL STREET
ELKHORN, WISCONSIN. 53121.

ALSO: JAVID ASSOCIATES SERVICES
2235 WONDVIEW ROAD
TIMONIUM, MD. 21093

SURVEYED BY: JENSEN SURVEYING & MAPPING S.C.
45 SOUTH WISCONSIN ST. RO. BOX 322
ELKHORN, WISCONSIN. 53121
(414) 723-3434

ELEVATIONS TAKEN: AUGUST 27, 1987.

MANHOLE INFORMATION

- | | | |
|-----|--------------------|-------------|
| 1 - | SANITARY SEWER | FLows SOUTH |
| | RIM EL. = 1017.53 | |
| | FLOW EL. = 1008.71 | |
| 2 - | SANITARY SEWER | FLows SOUTH |
| | RIM EL. = 1015.08 | |
| | FLOW EL. = 1007.11 | |
| 3 - | STORM SEWER | FLows SOUTH |
| | RIM EL. = 1016.99 | |
| | FLOW EL. = 1010.93 | |
| 4 - | STORM SEWER | FLow SOUTH |
| | RIM EL. = 1014.44 | |
| | FLOW EL. = 1008.54 | |

BENCHMARK INFORMATION

- 19 S. BOLT OF HYDRANT AT INTERSECTION OF WESTWARD DRIVE AND S. CHURCH 1017.56

NOTE: DECIMAL POINT IN ELEVATION INDICATES ITS LOCATION

NOTE: CURB ELEVATIONS TAKEN IN THE FLOW LINE.

Copyright © 1987 by Jensen Surveying & Mapping S.C.

All rights reserved. No part of this survey plat may be reproduced or transmitted in any form by any means - graphic, electronic, or mechanical, including photocopying, tracing, or information storage and retrieval systems - without permission in writing from Thomas P.A. Jensen, Jensen Surveying & Mapping S.C.




I, Thomas P.A. Jensen, Wisconsin Registered Land Surveyor, do hereby certify that this survey was performed by me, or under my direction, in full compliance with the owner's/agent's instructions and Chapter A-E 5 of the Wisconsin Administrative Code "Minimum Standards For Property Surveys"; and that this map is an accurate representation thereof to the best of my knowledge and belief.

Note: This survey plat is not certified unless signed and sealed in red ink.

Thomas P.A. Jensen R.L.S.-1084
Jensen Surveying & Mapping S.C.



"THE LOCATION OF UNDERGROUND FACILITIES OR STRUCTURES SHOWN ARE BASED UPON AVAILABLE RECORDS AT THE TIME THE PLANS WERE PREPARED AND ARE NOT GUARANTEED TO BE COMPLETE OR CORRECT. IT IS THE RESPONSIBILITY OF THE CONTRACTOR TO CONTACT ALL PUBLIC AND/OR PRIVATE UTILITIES SERVING THE AREA TO DETERMINE THE PRESENT EXTENT AND EXACT LOCATION OF THEIR FACILITIES BEFORE BEGINNING WORK. THE CONTRACTOR SHALL PROVIDE ADEQUATE PROTECTION OF THESE FACILITIES DURING THE COURSE OF THE WORK."

BEARINGS REFERENCED TO
CERTIFIED SURVEY MAP 623.

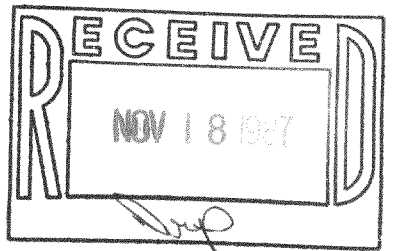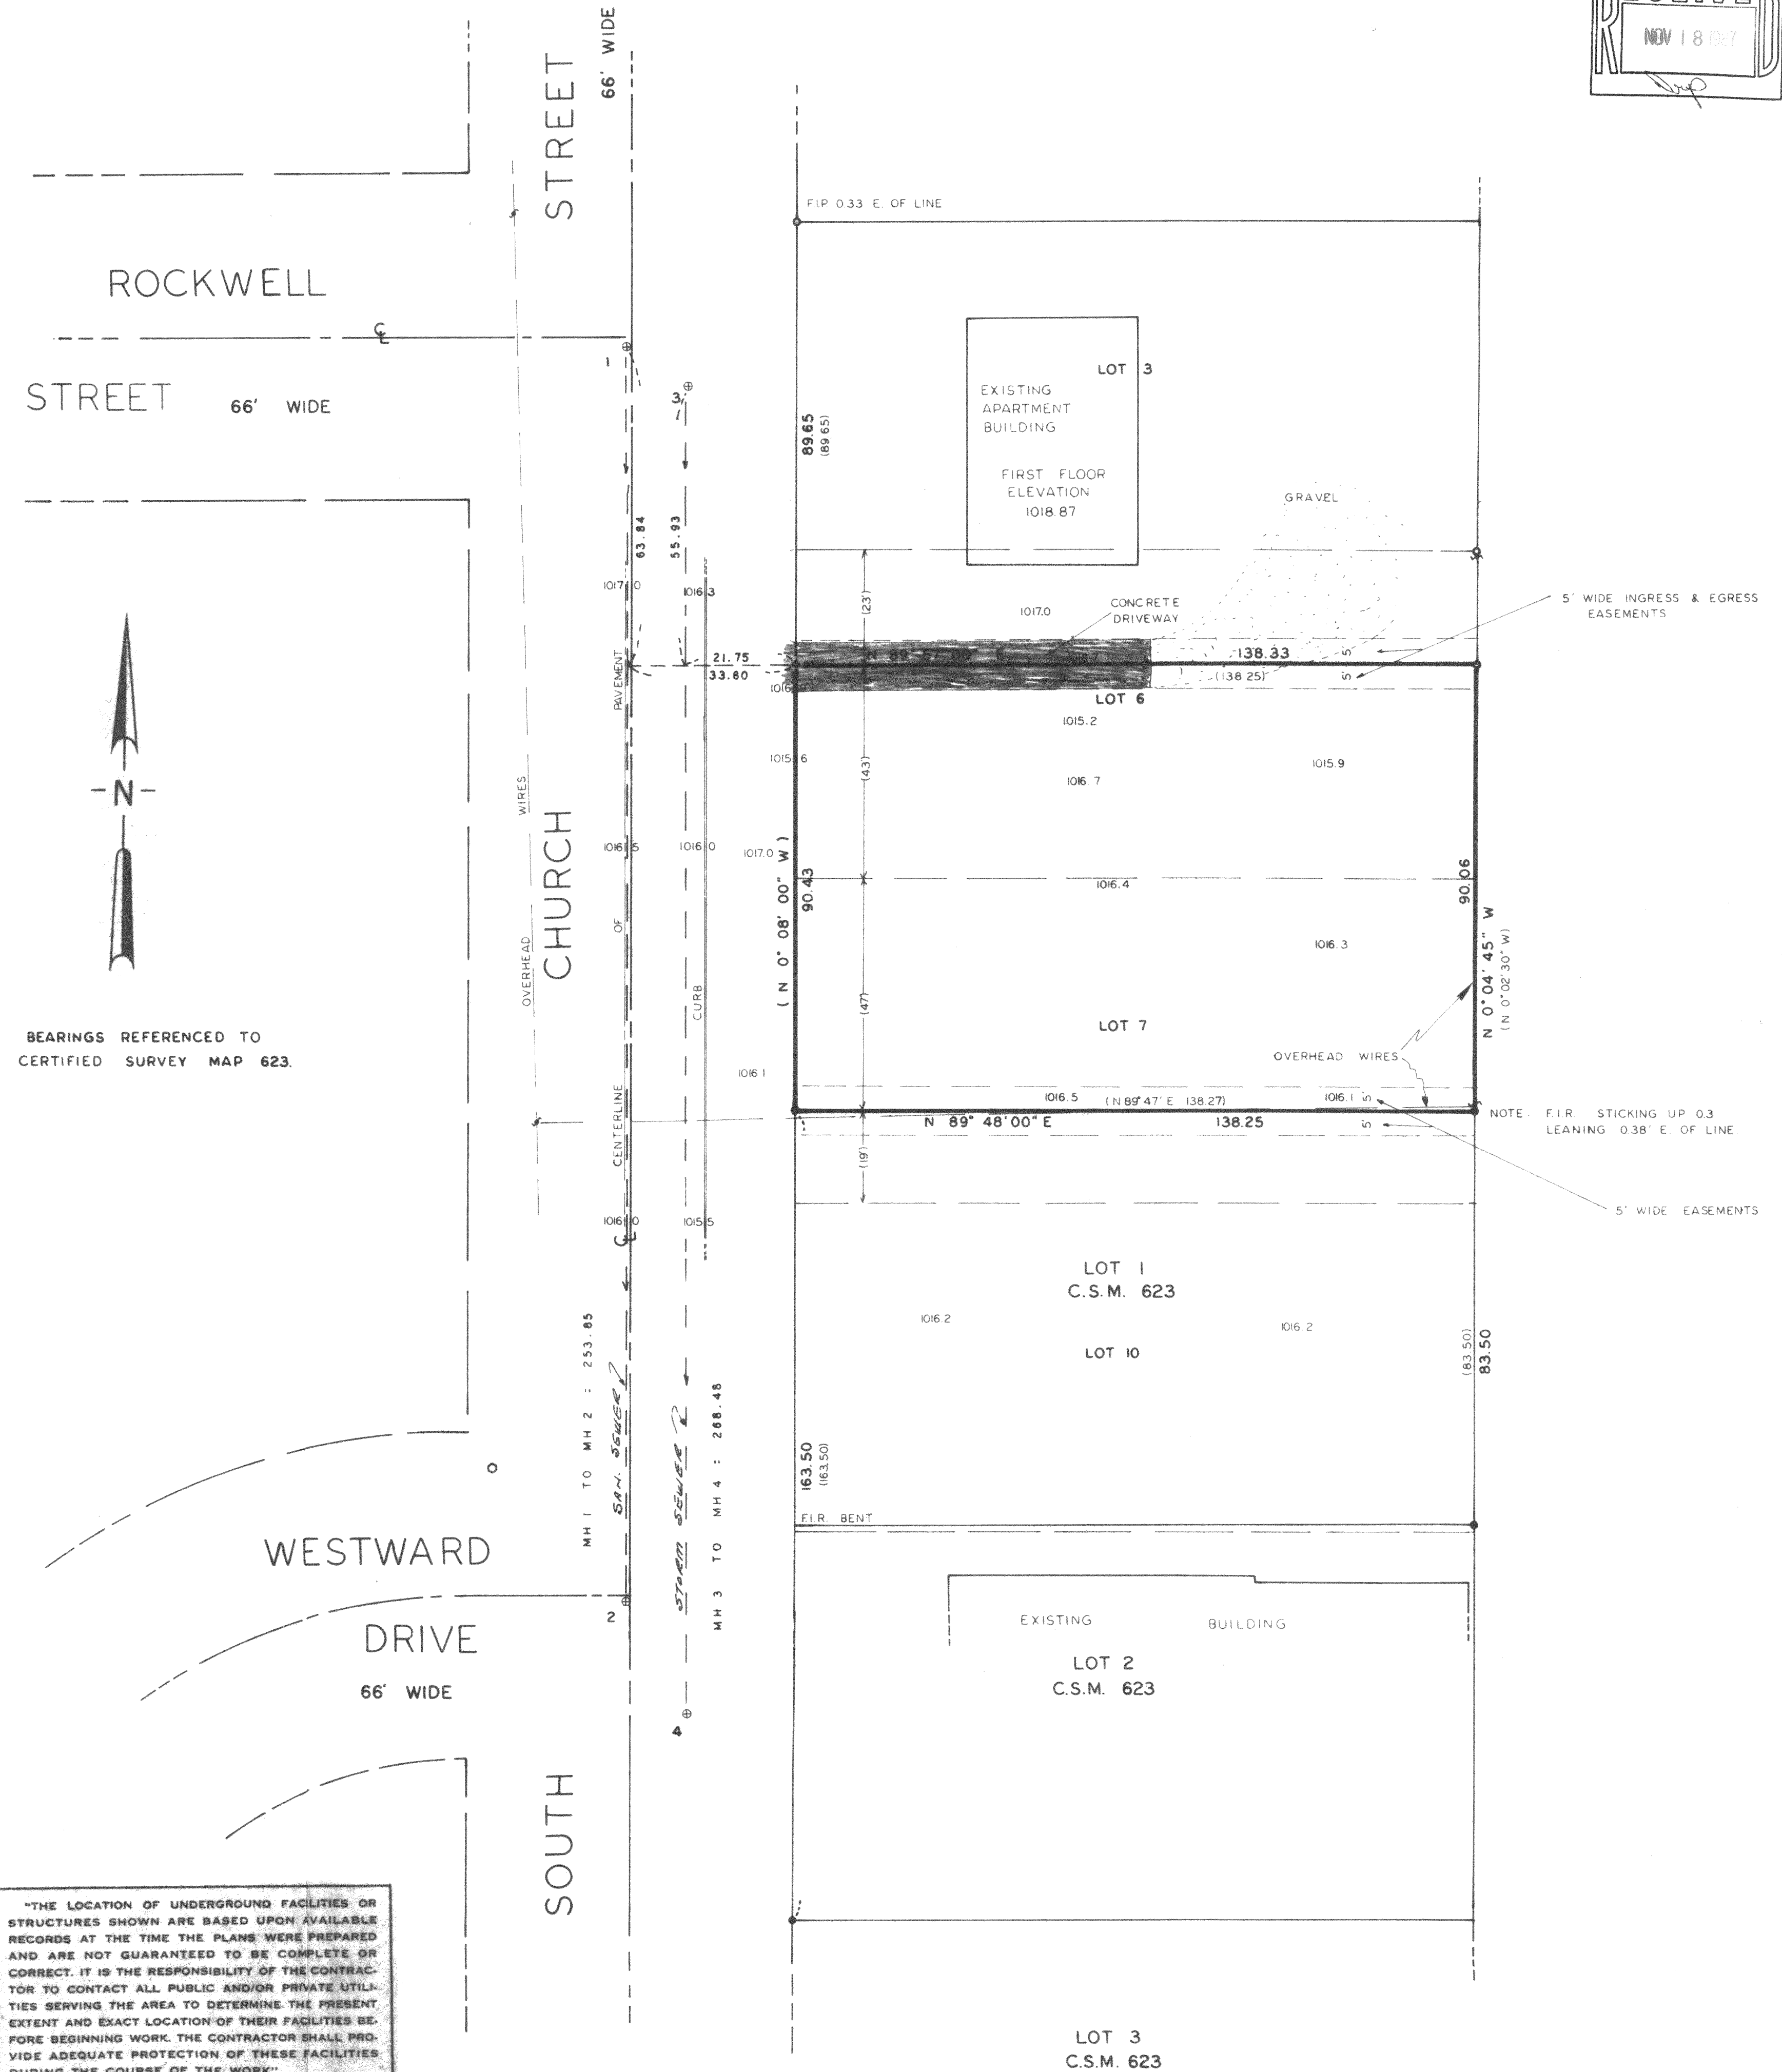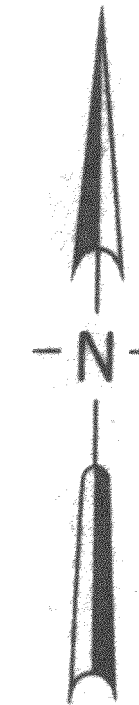

Mapping date: _____

Revisions: _____

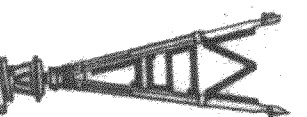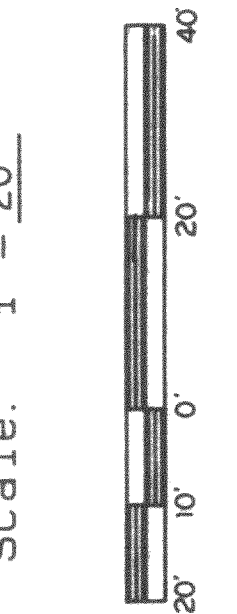

JENSEN SURVEYING & MAPPING S.C.

45 South Wisconsin Street P.O. Box 322
Elkhorn, Wisconsin 53121
(414) 723-3434

Legend

- FOUND IRON PIPE
- FOUND IRON ROD 3/4"
- + FOUND CROSSCUT
- ✦ POWER POLE
- (?) RECORDED AS DIMENSION

Sheet no. 1 of 1 sheets.

Job reference number
1987.086

1987.086