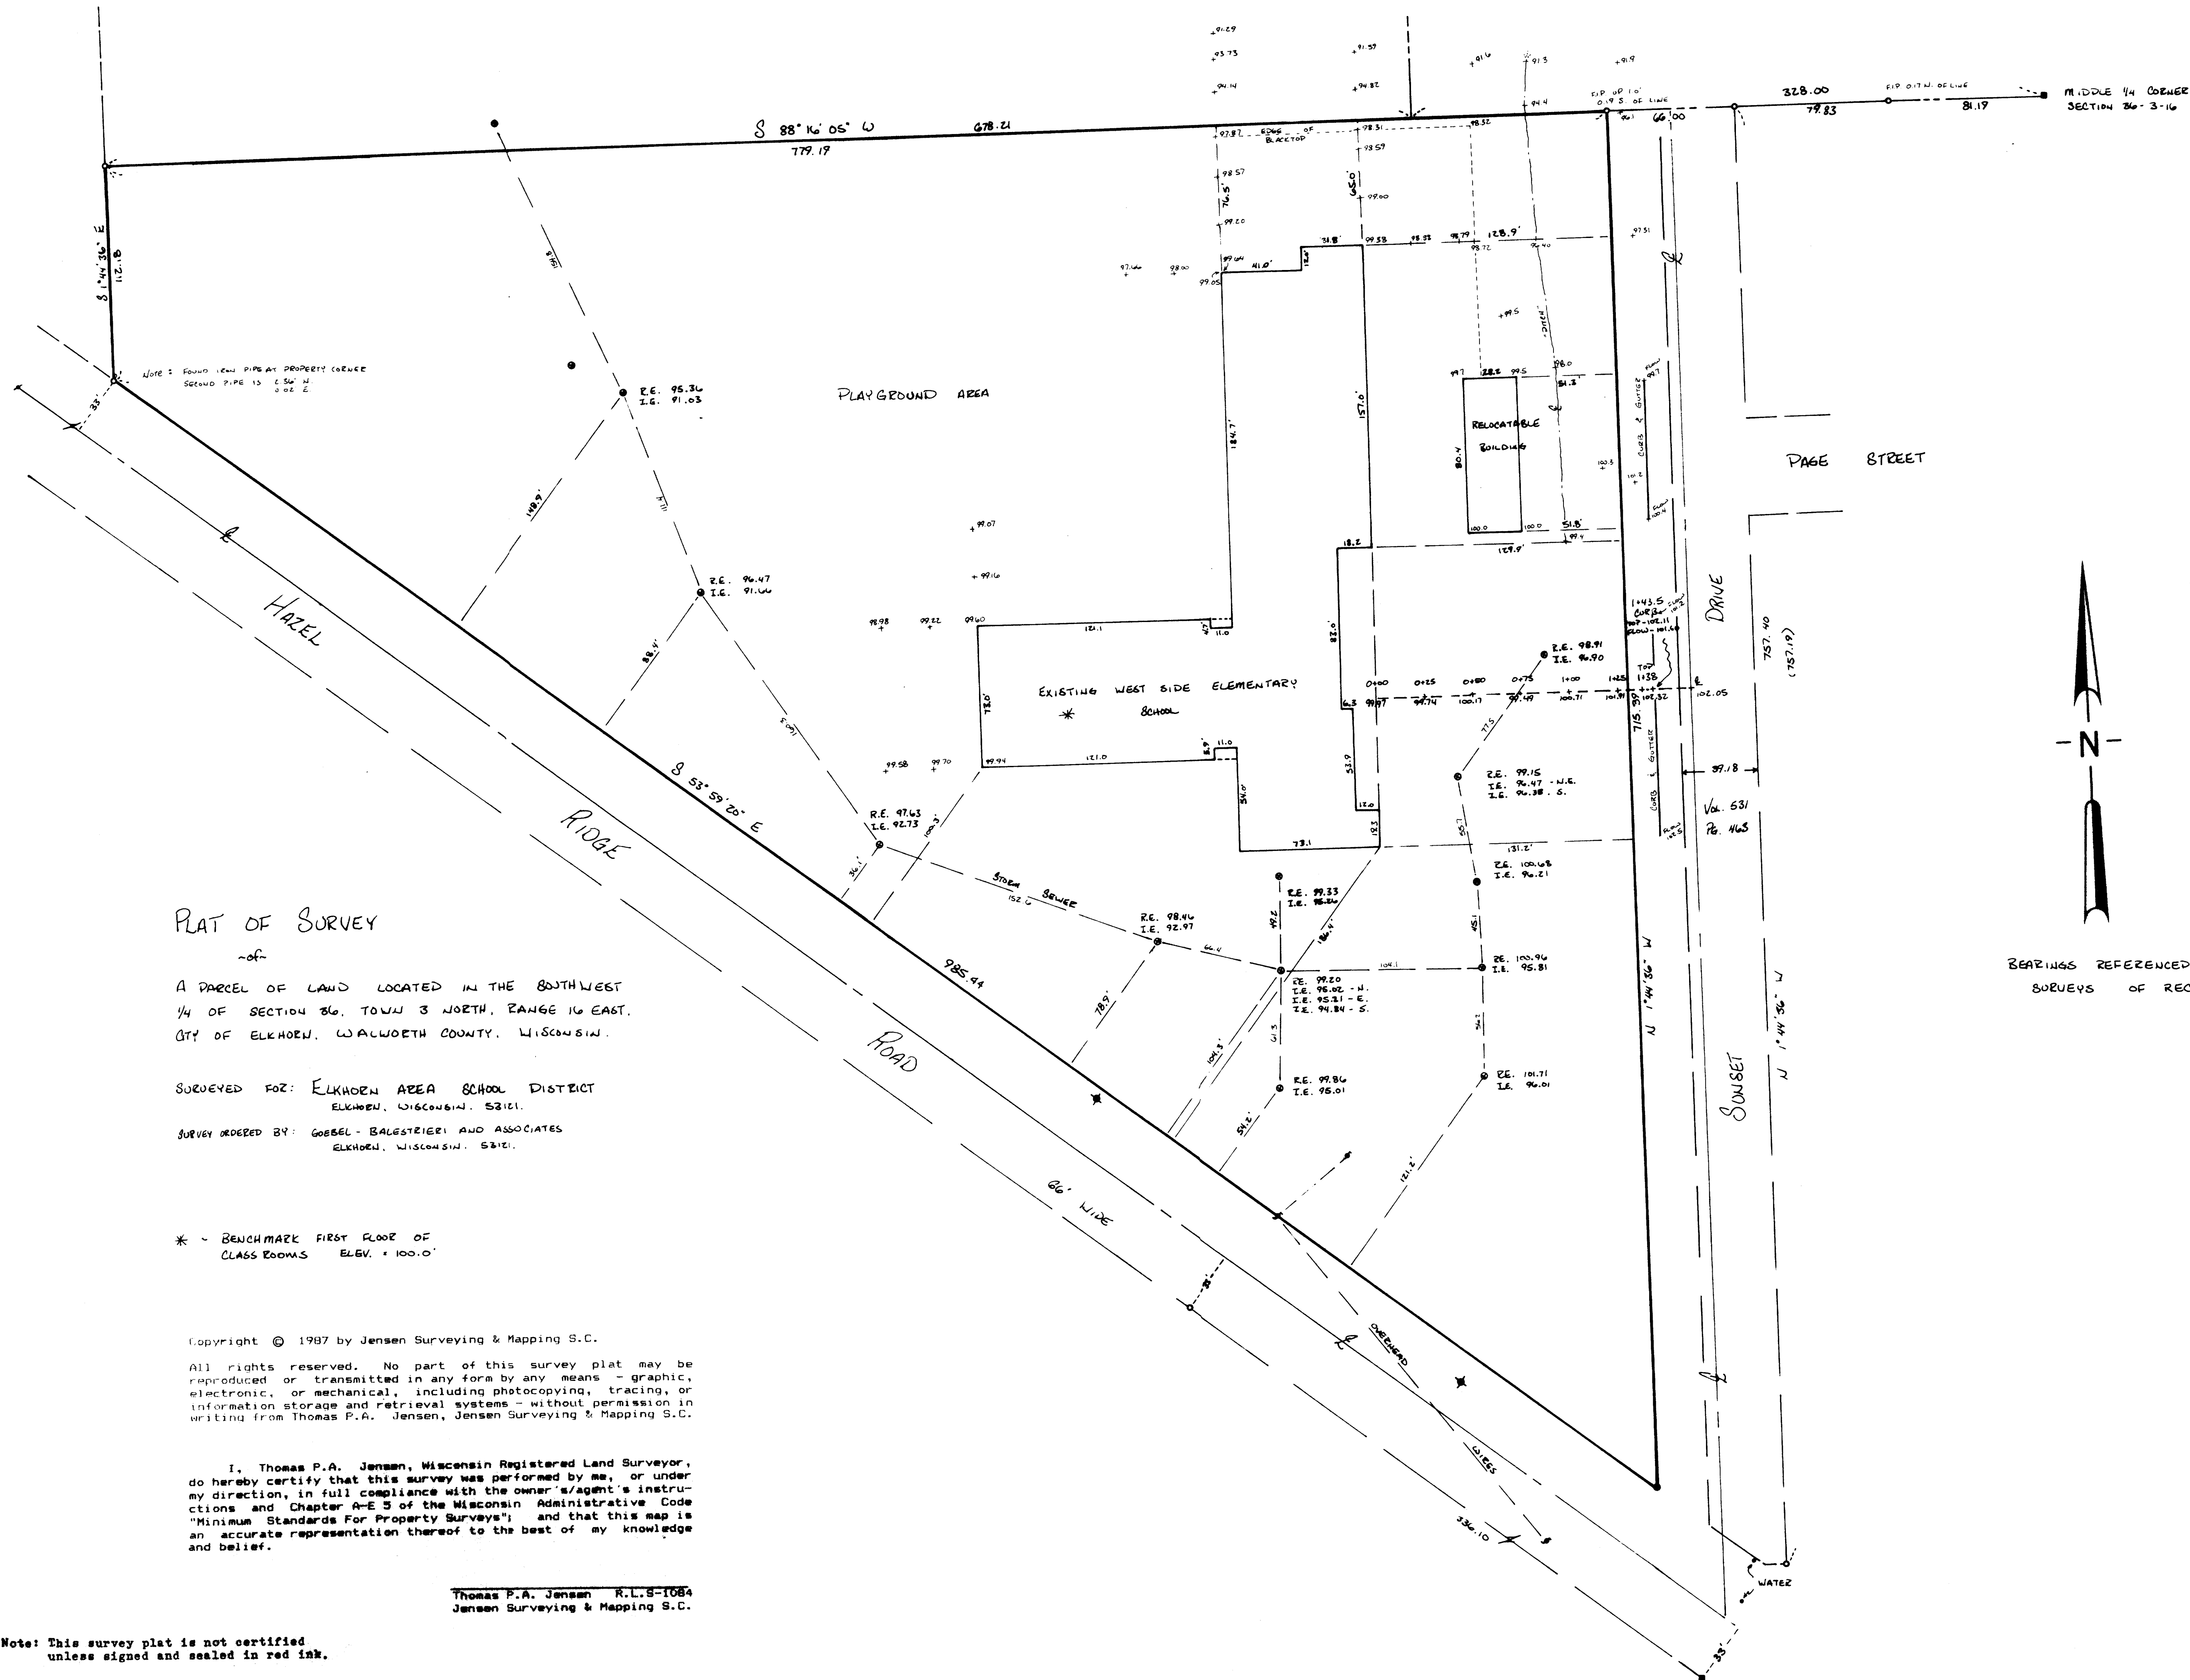


BEARINGS REFERENCED TO PREVIOUS
SURVEYS OF RECORD.

PLAT OF SURVEY

-of-

A PARCEL OF LAND LOCATED IN THE SOUTHWEST
1/4 OF SECTION 36, TOWN 3 NORTH, RANGE 16 EAST,
CITY OF ELKHORN, WALWORTH COUNTY, WISCONSIN.

SURVEYED FOR: ELKHORN AREA SCHOOL DISTRICT
ELKHORN, WISCONSIN. 53121.

SURVEY ORDERED BY: GOBBEL - BALESTRIERI AND ASSOCIATES
ELKHORN, WISCONSIN. 53121.

* - BENCHMARK FIRST FLOOR OF
CLASS ROOMS ELEV. = 100.0'

Copyright © 1987 by Jensen Surveying & Mapping S.C.

All rights reserved. No part of this survey plat may be
reproduced or transmitted in any form by any means - graphic,
electronic, or mechanical, including photocopying, tracing, or
information storage and retrieval systems - without permission in
writing from Thomas P.A. Jensen, Jensen Surveying & Mapping S.C.

I, Thomas P.A. Jensen, Wisconsin Registered Land Surveyor,
do hereby certify that this survey was performed by me, or under
my direction, in full compliance with the owner's/agent's instru-
ctions and Chapter A-E 5 of the Wisconsin Administrative Code
"Minimum Standards For Property Surveys"; and that this map is
an accurate representation thereof to the best of my knowledge
and belief.

Thomas P.A. Jensen R.L.S-1084
Jensen Surveying & Mapping S.C.

Note: This survey plat is not certified
unless signed and sealed in red ink.

Mapping date: 6-11-87

Revisions: 6-17-87

Scale: 1" = 40'



JENSEN SURVEYING & MAPPING S.C.

45 South Wisconsin Street P.O. Box 322
Elkhorn, Wisconsin. 53121
(414) 723-3434

Legend

- FOUND CONCRETE MONUMENT
- FOUND IRON PIPE
- FOUND NAIL
- SET IRON ROD 3/4"
- UTILITY POLE
- MANHOLE
- CATCH BASIN

Sheet no. 1 of 1 sheets.

Job reference number

1987.063

1987.063