

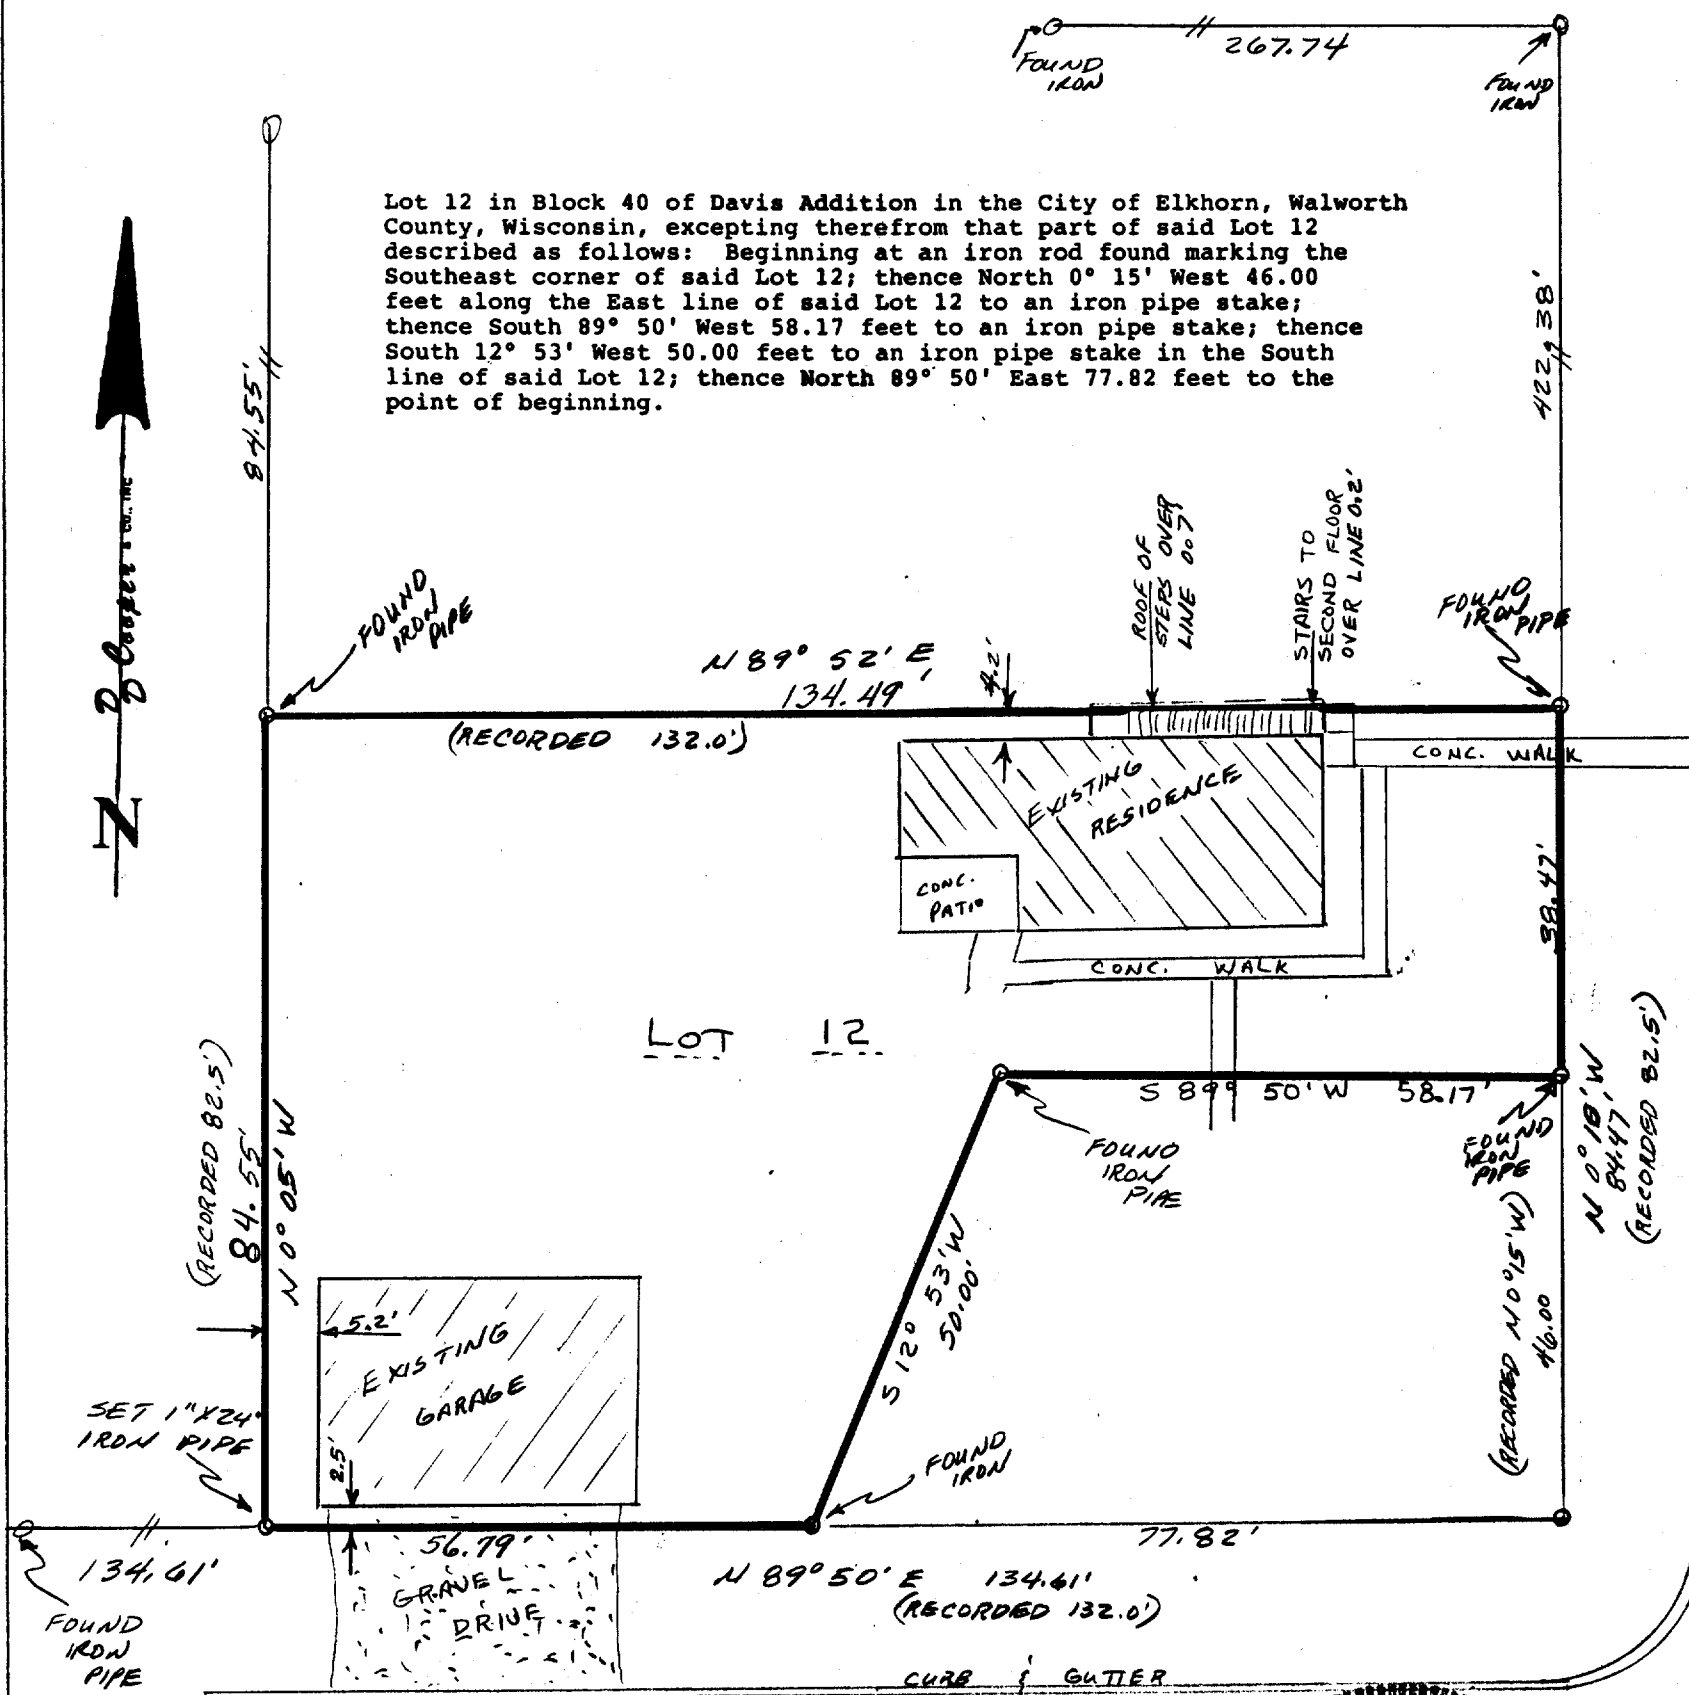


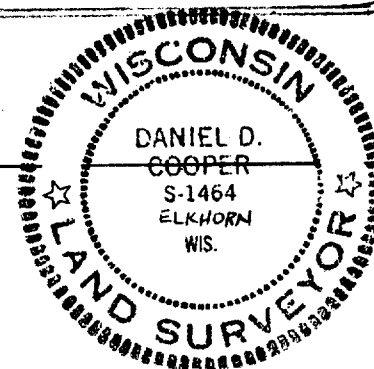

SCALE 1" = 20'

Survey Ordered by Modern Realty
Elkhorn

Bearing Reference: Northerly line
of First Ave., assumed to Bear
N 89° 50' E

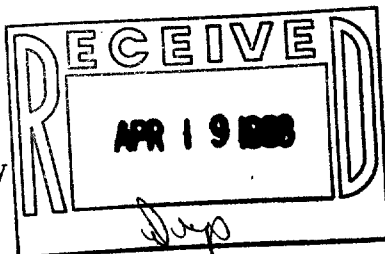

I hereby certify that I have surveyed the
property described hereon and that the
map shown hereon is a true and accurate
representation thereof to the best of my
professional knowledge and belief.

Dated this 14 day of Nov., 1987

Daniel D. Cooper
Daniel D. Cooper, RLS No. S-1464

D. Cooper & CO., INC
Rt. 4 Box 508B • Elkhorn WI 53121

DRAWING NO. 3169-S

4-499