



61-63

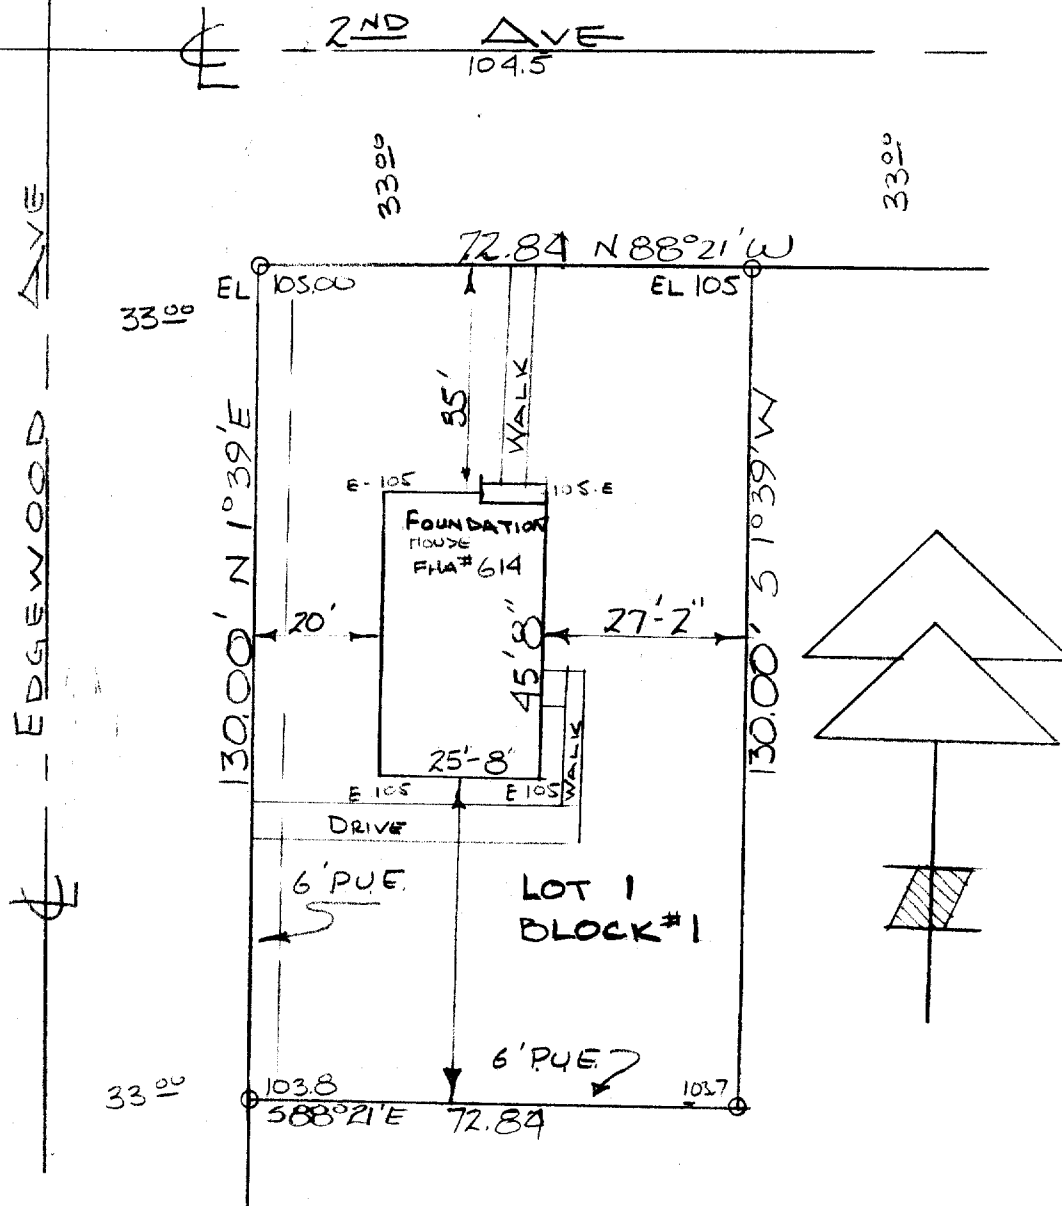

DESCRIPTION: Lot 1 of Block 1 of Edgewood Subdivision, in the City of Elmhorn, Walworth County, Wisconsin.

CERTIFICATE: I, James F. Biagi, surveyor, do hereby certify that I have surveyed the property herein described, and that the location of all the improvements are as shown on the drawing above.

October 11, 1961

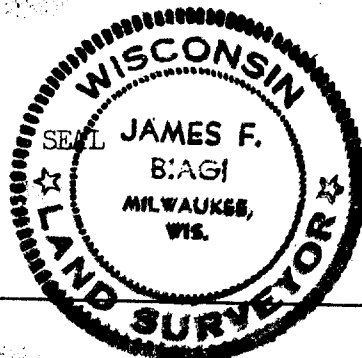

James F. Biagi
James F. Biagi RLS 272

YE-1