

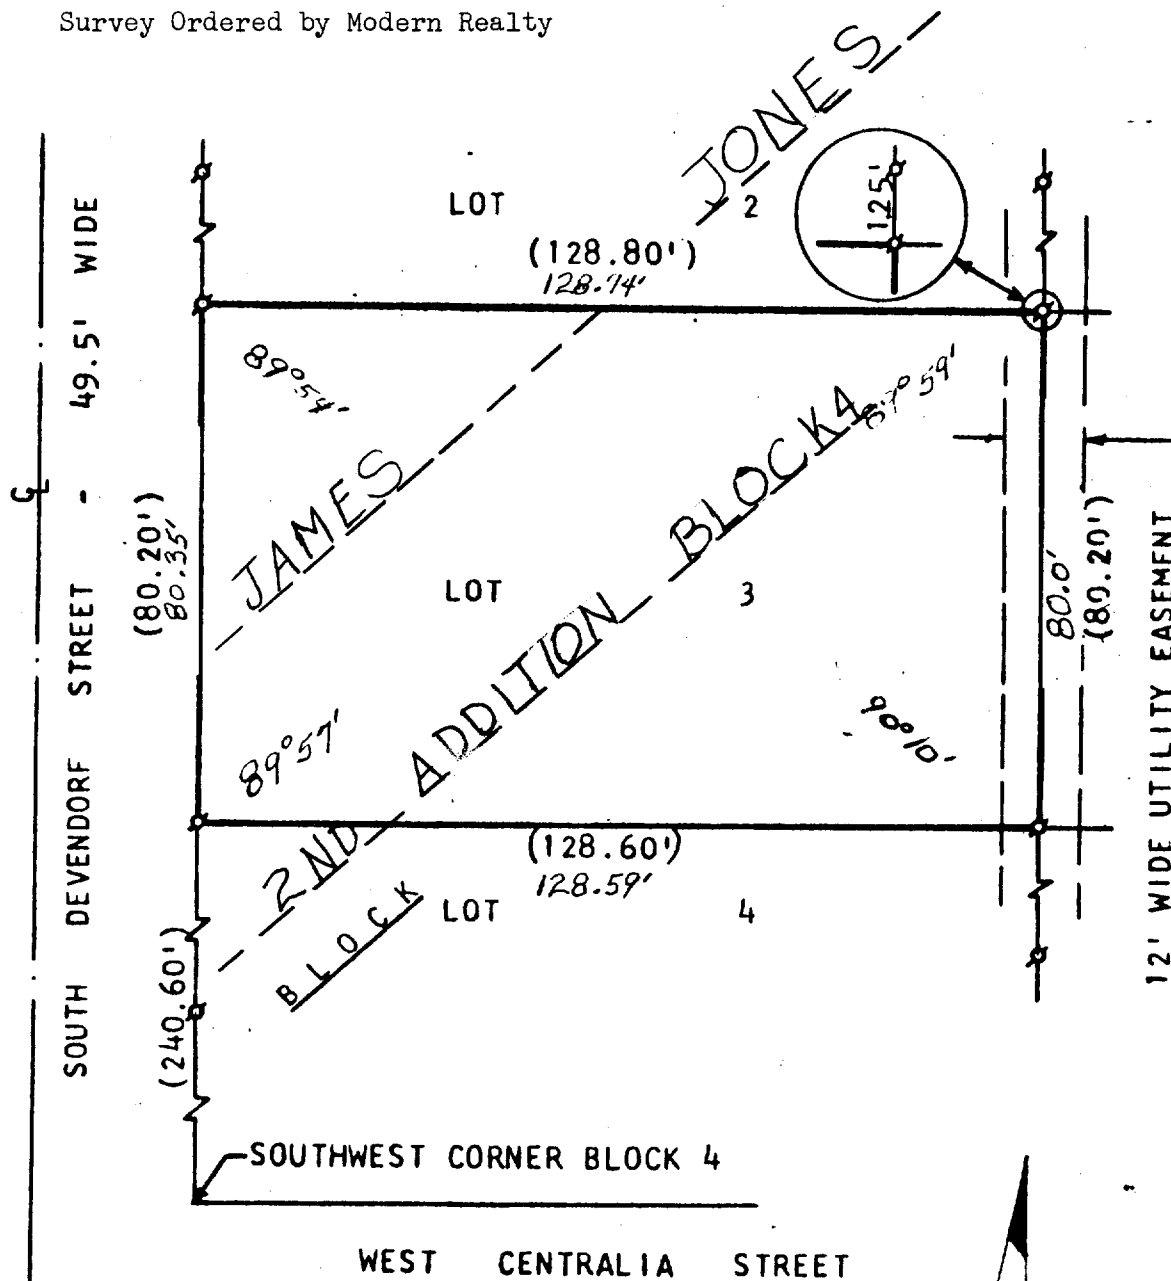


Survey Ordered by Modern Realty

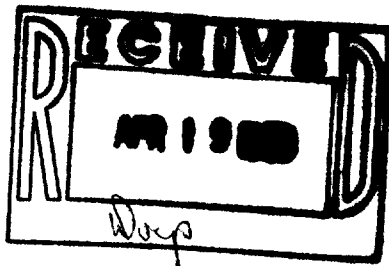

PLAT OF SURVEY OF LOT 3, BLOCK 4, JAMES JONES
2ND ADDITION, CITY OF ELKHORN, WALWORTH COUNTY,
WISCONSIN.

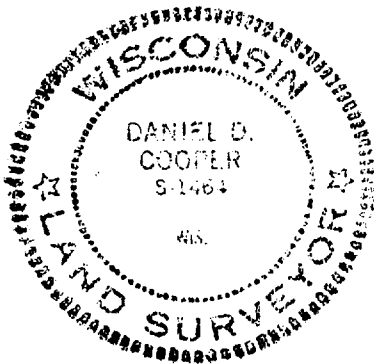

SCALE: 1"=30'

() - AS PLATTED
x - IRON PIPE FOUND
o - IRON PIPE SET

I HEREBY CERTIFY THAT I HAVE SURVEYED THE PROPERTY DESCRIBED
HEREON AND THAT THE ABOVE MAP IS A TRUE AND ACCURATE REPRESENTATION
THEREOF TO THE BEST OF MY PROFESSIONAL KNOWLEDGE AND BEHALF.

DATED THIS 25th DAY OF Aug., 1987

Daniel D. Cooper
DANIEL D. COOPER, RLS NO. S- 1464

D. D. COOPER & CO., INC.
Daniel D. Cooper
Rt. 4 Box 508B
Elkhorn, WI 53121