
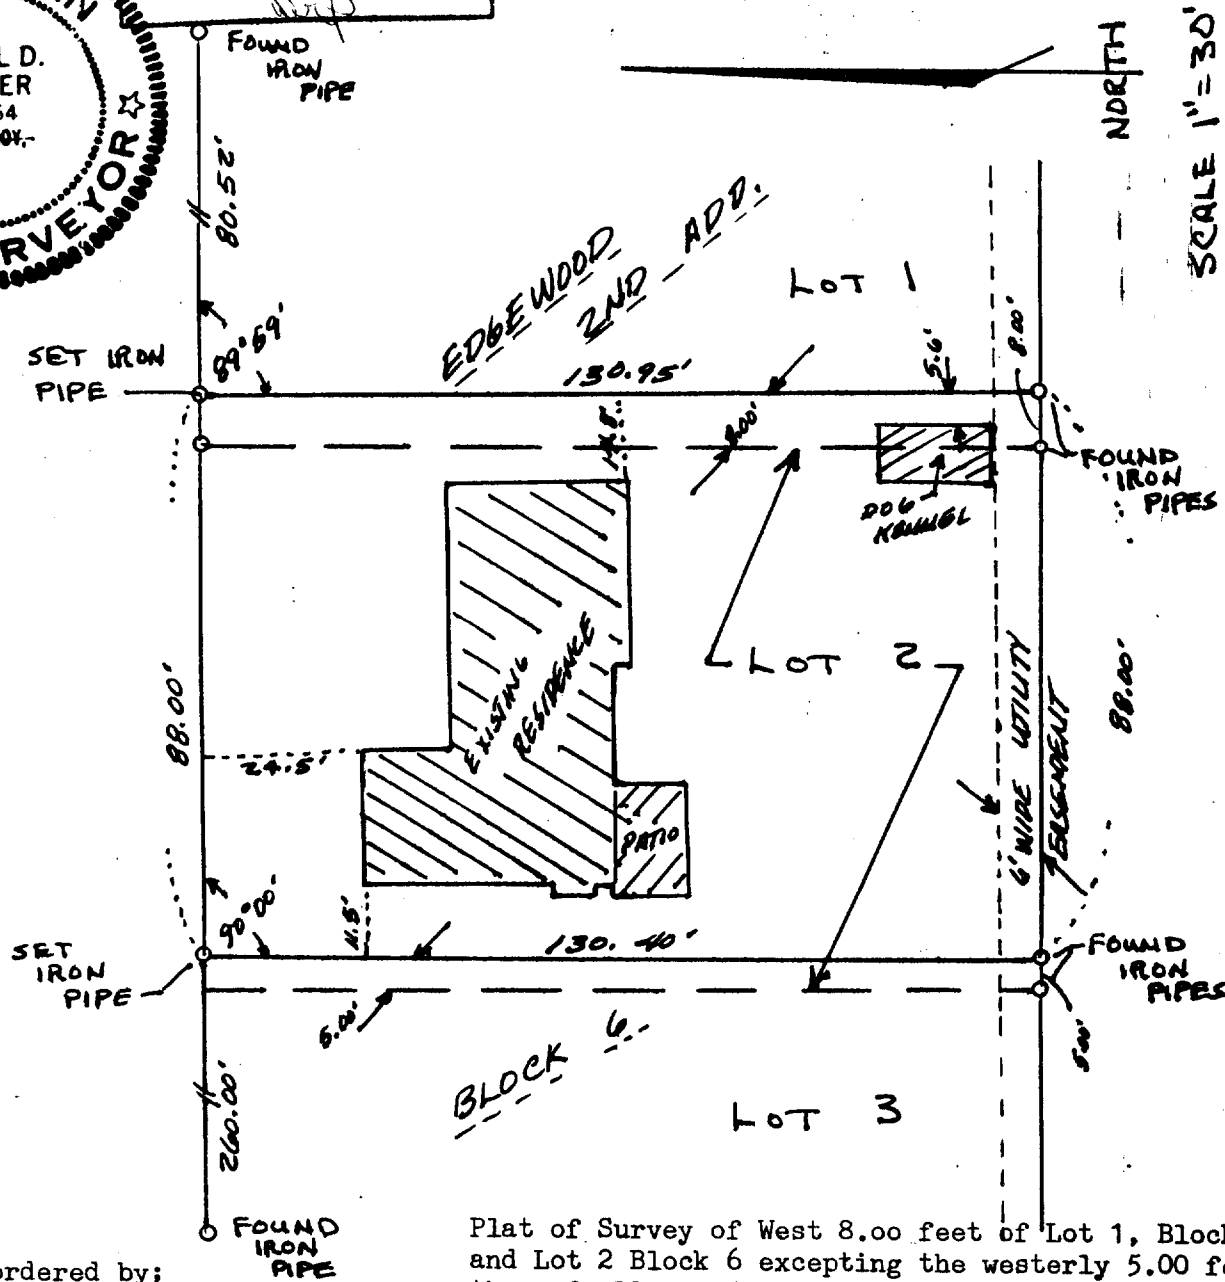


DANIEL D. COOPER
Registered Land Surveyor

APR 19 1988

Route 4 Box 5088
Elkhorn WI 53121
Phone-414-723-6265

SURVEYING & PLANNING
SUBDIVISIONS - LOT SURVEYS
CONSTRUCTION STAKING - MAPPING

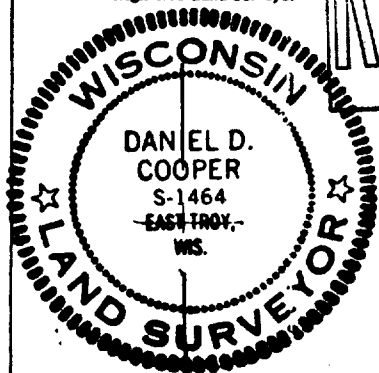

- survey ordered by;
Modern Realty

Plat of Survey of West 8.00 feet of Lot 1, Block 6
and Lot 2 Block 6 excepting the westerly 5.00 feet
thereof all in Edgewood 2nd Addition to the City of
Elkhorn, Walworth County, Wisconsin.

I hereby certify that I have surveyed the property described hereon and that the
above map is a true and accurate representation of the lot lines and the
principal structures thereon to the best of professional knowledge and belief.

Dated this 29 day of Oct., 1982

Daniel D Cooper
Daniel D. Cooper, RLS No. S-1464

Reviewed and Recertified to this 25 day of May, 1987

Daniel D Cooper
Daniel D. Cooper

DRAWING NO. 1814 4-502