


[illegible]

Dated this 22 day of Mar., 1988

Scale 1"=20'

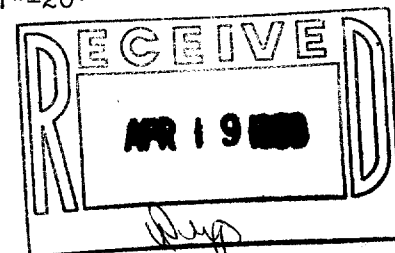

DRAWING NO. 3205 4-506