


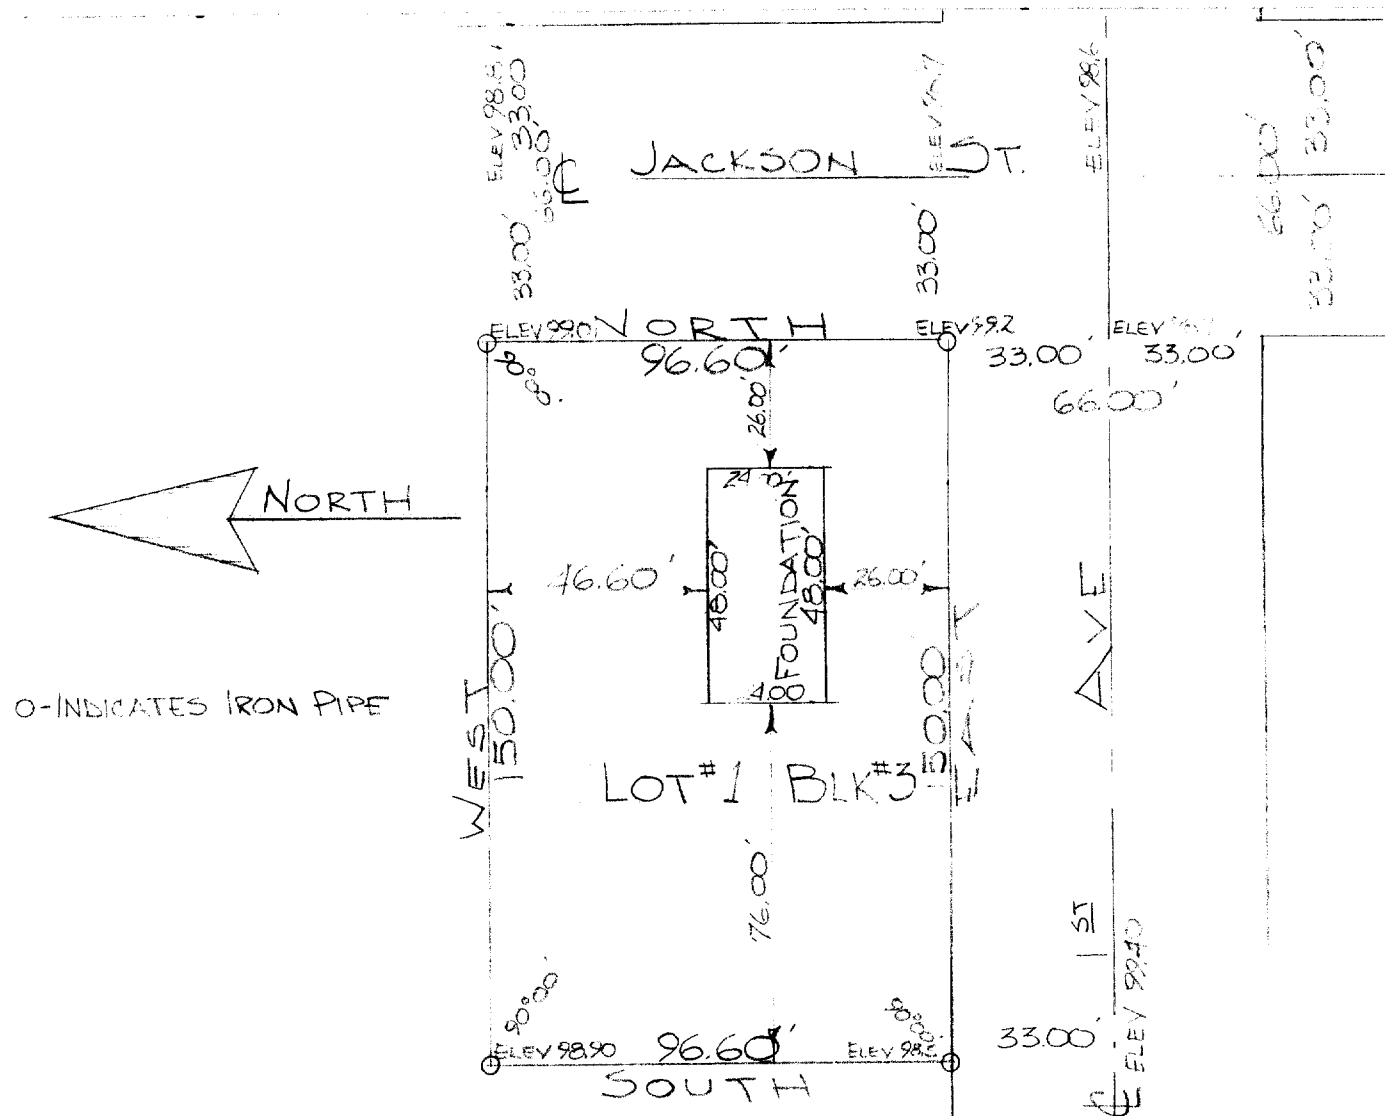

DESCRIPTION: Lot 1 of Block #3 in Fairlane Subdivision, in the City of Elkhorn, Walworth County, Wisconsin.

CERTIFICATE: I, James F. Biagi, surveyor, do hereby certify that I have surveyed the property hereon described and that the foundation is as shown on the drawing above.

Aug. 17, 1962.

James F. Biagi
James F. Biagi (RLS 272)

