


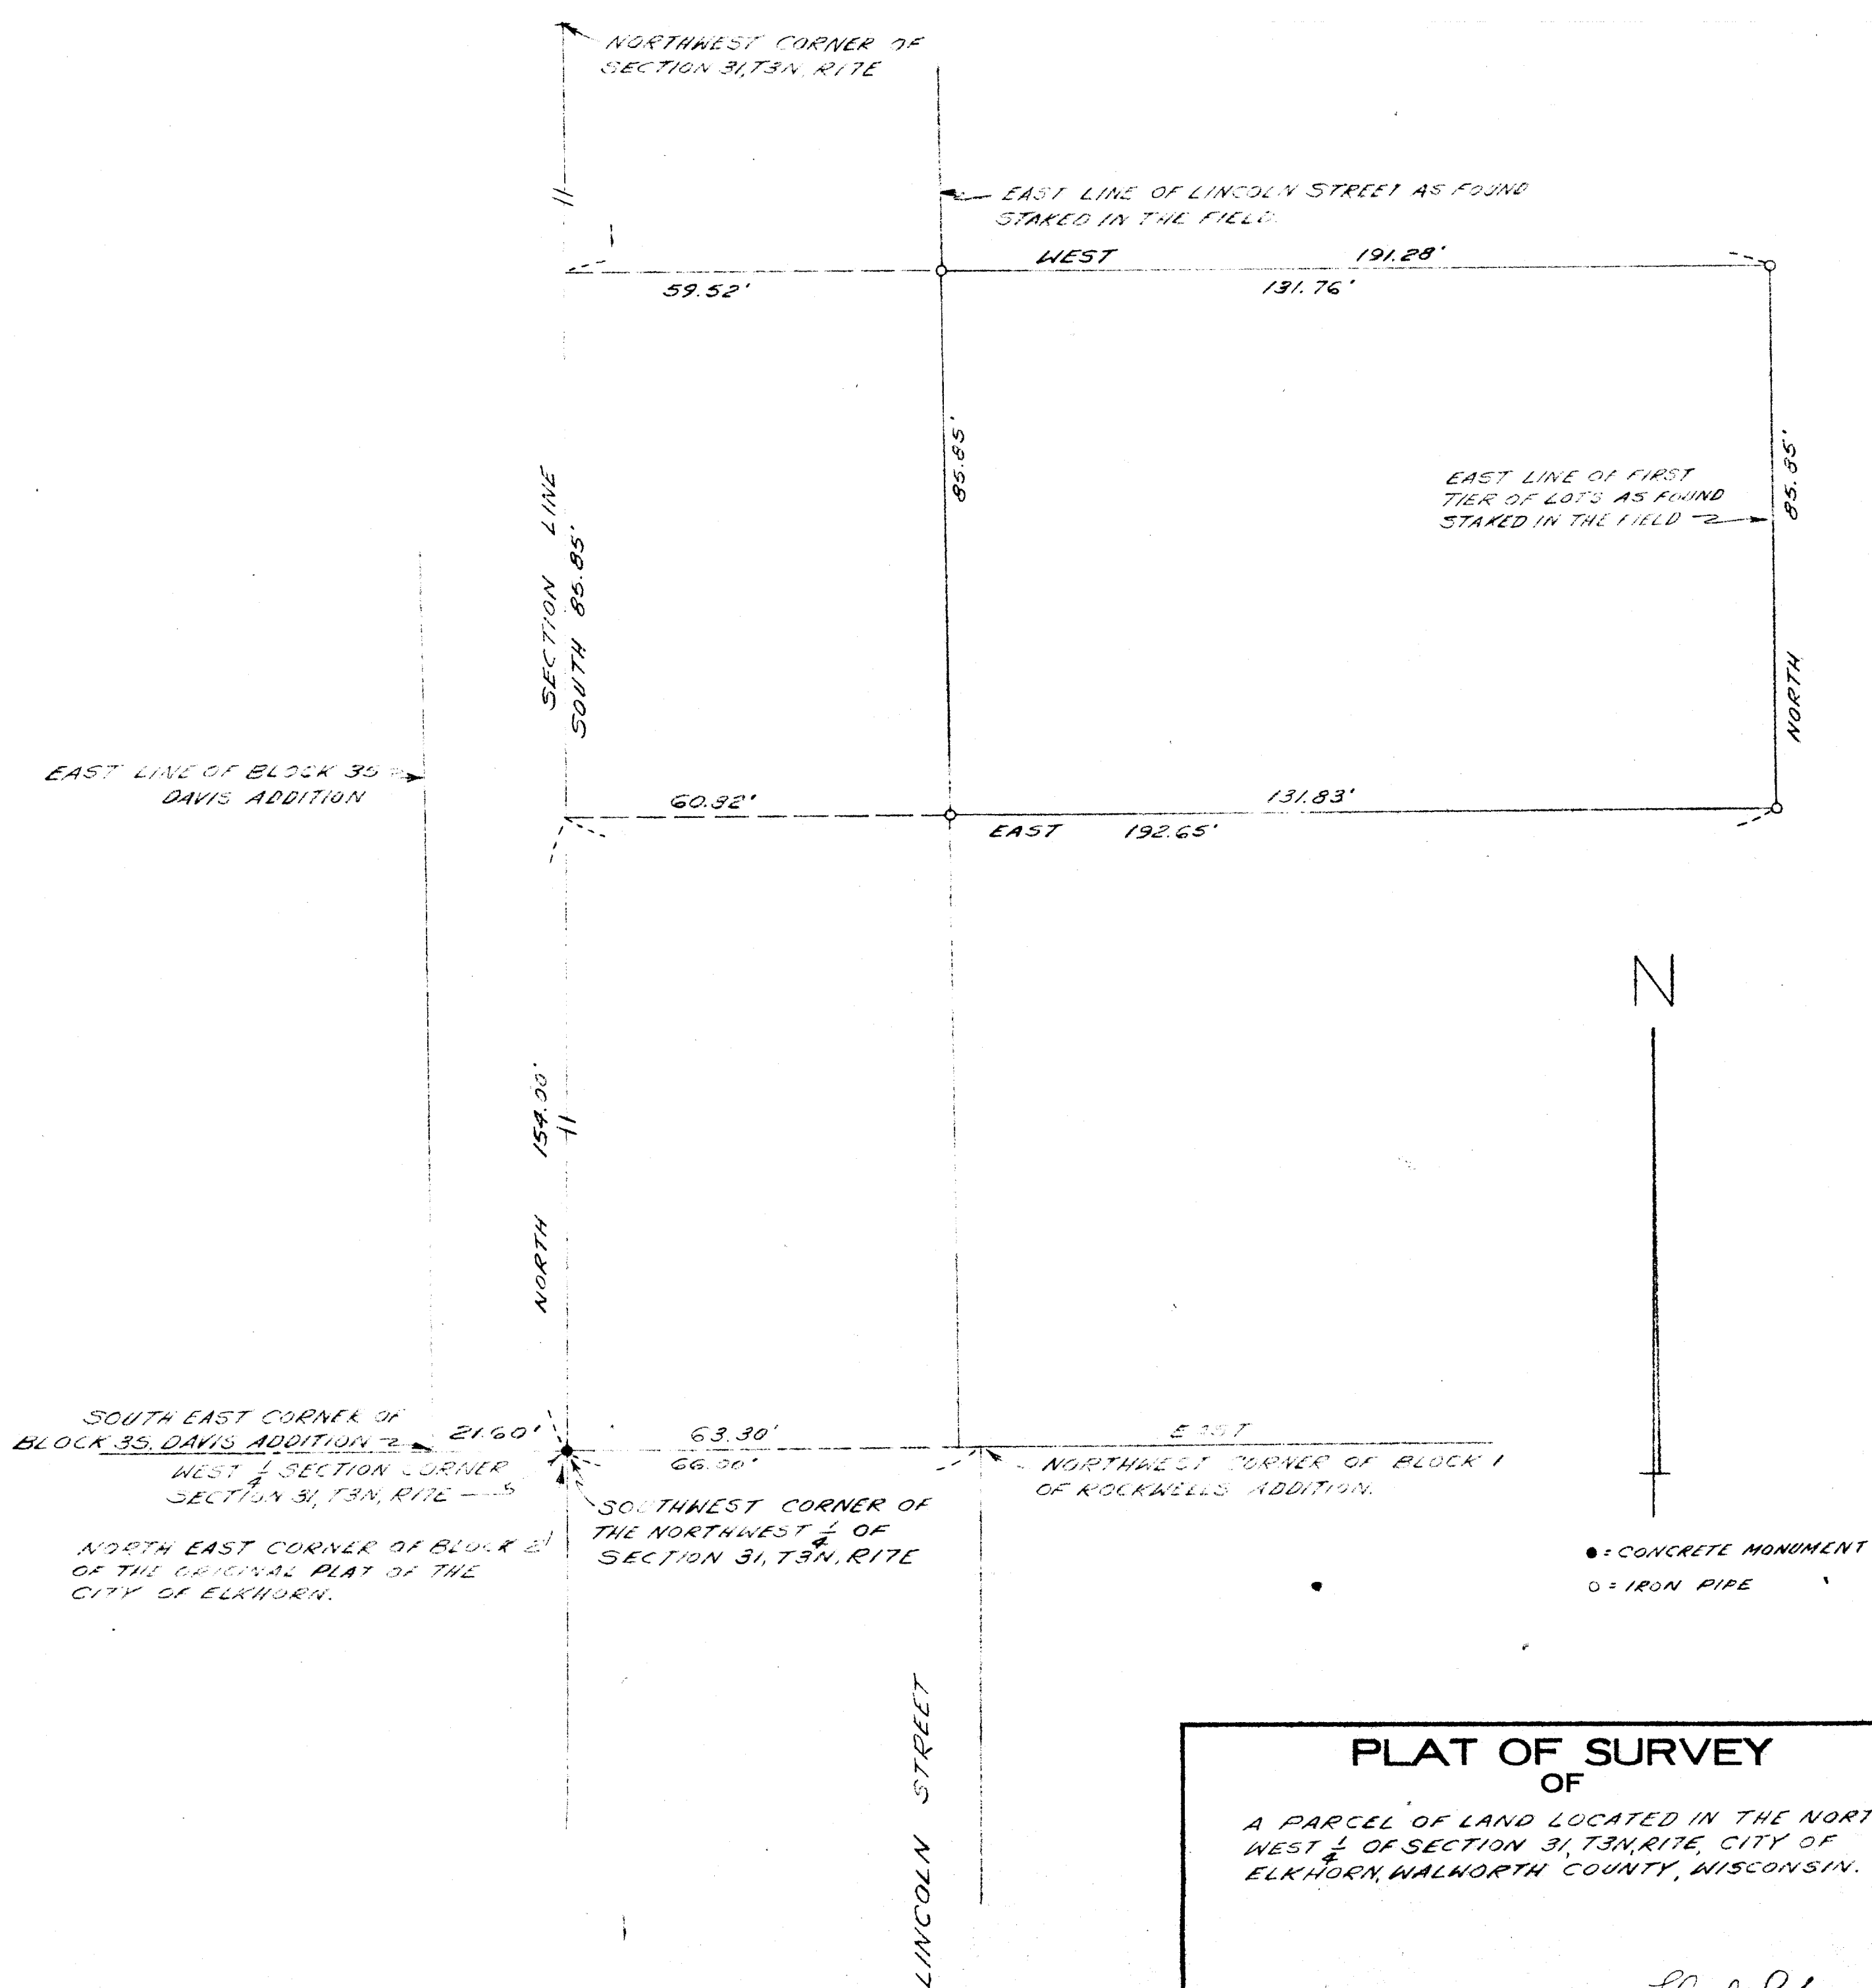

PLAT OF SURVEY OF

A PARCEL OF LAND LOCATED IN THE NORTH
WEST 1/4 OF SECTION 31, T3N, R17E, CITY OF
ELKHORN, WALWORTH COUNTY, WISCONSIN.

Lloyd L. Jensen
SURVEYOR

SCALE 1" = 20'

DATE Nov. 1961