

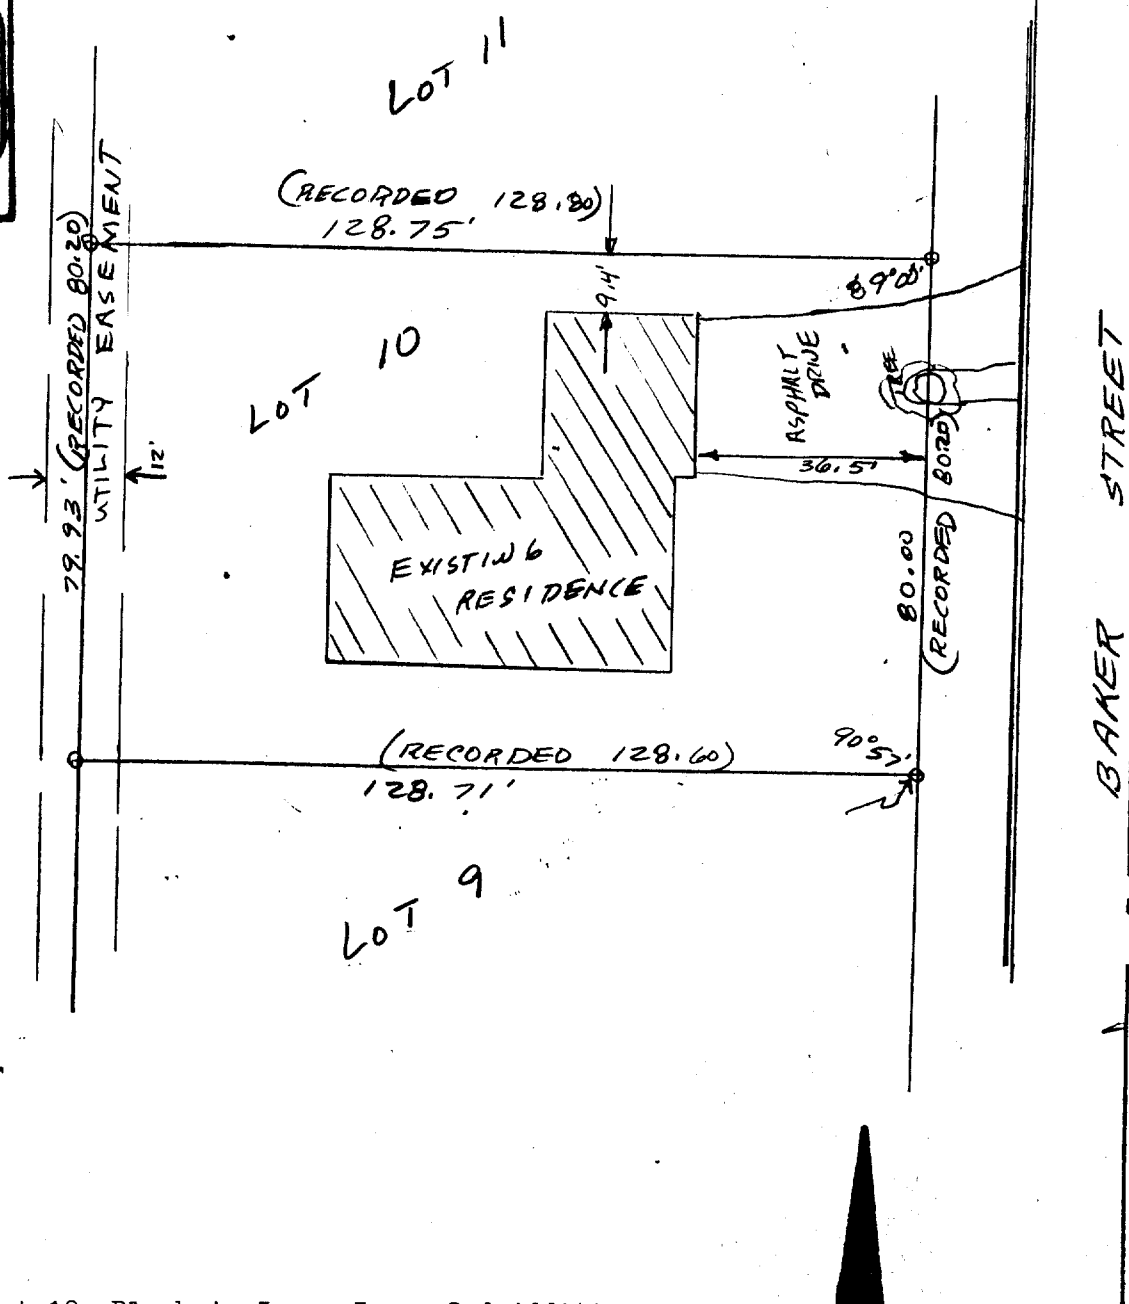


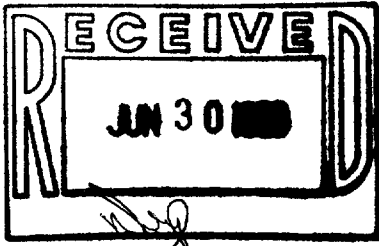

Plat of Survey of Lot 10, Block 4, James Jones 2nd Addition
 to the City of Elkhorn, Walworth County, Wisconsin.

Survey ordered by Modern Realty - Elkhorn

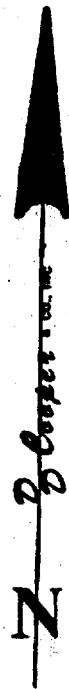


I hereby certify that I have surveyed the
 property described hereon and that the
 map shown hereon is a true and accurate
 representation thereof to the best of my
 professional knowledge and belief.

Dated this 21 day of June, 1998.

Daniel D. Cooper

Daniel D. Cooper, RLS No. S-1464

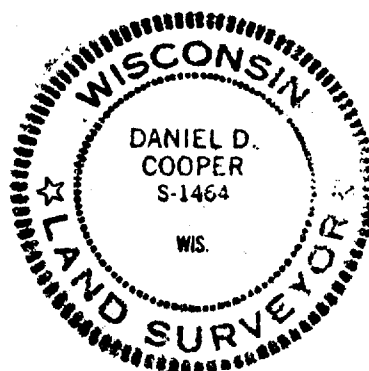

4-521
 Drawing No. 3261