

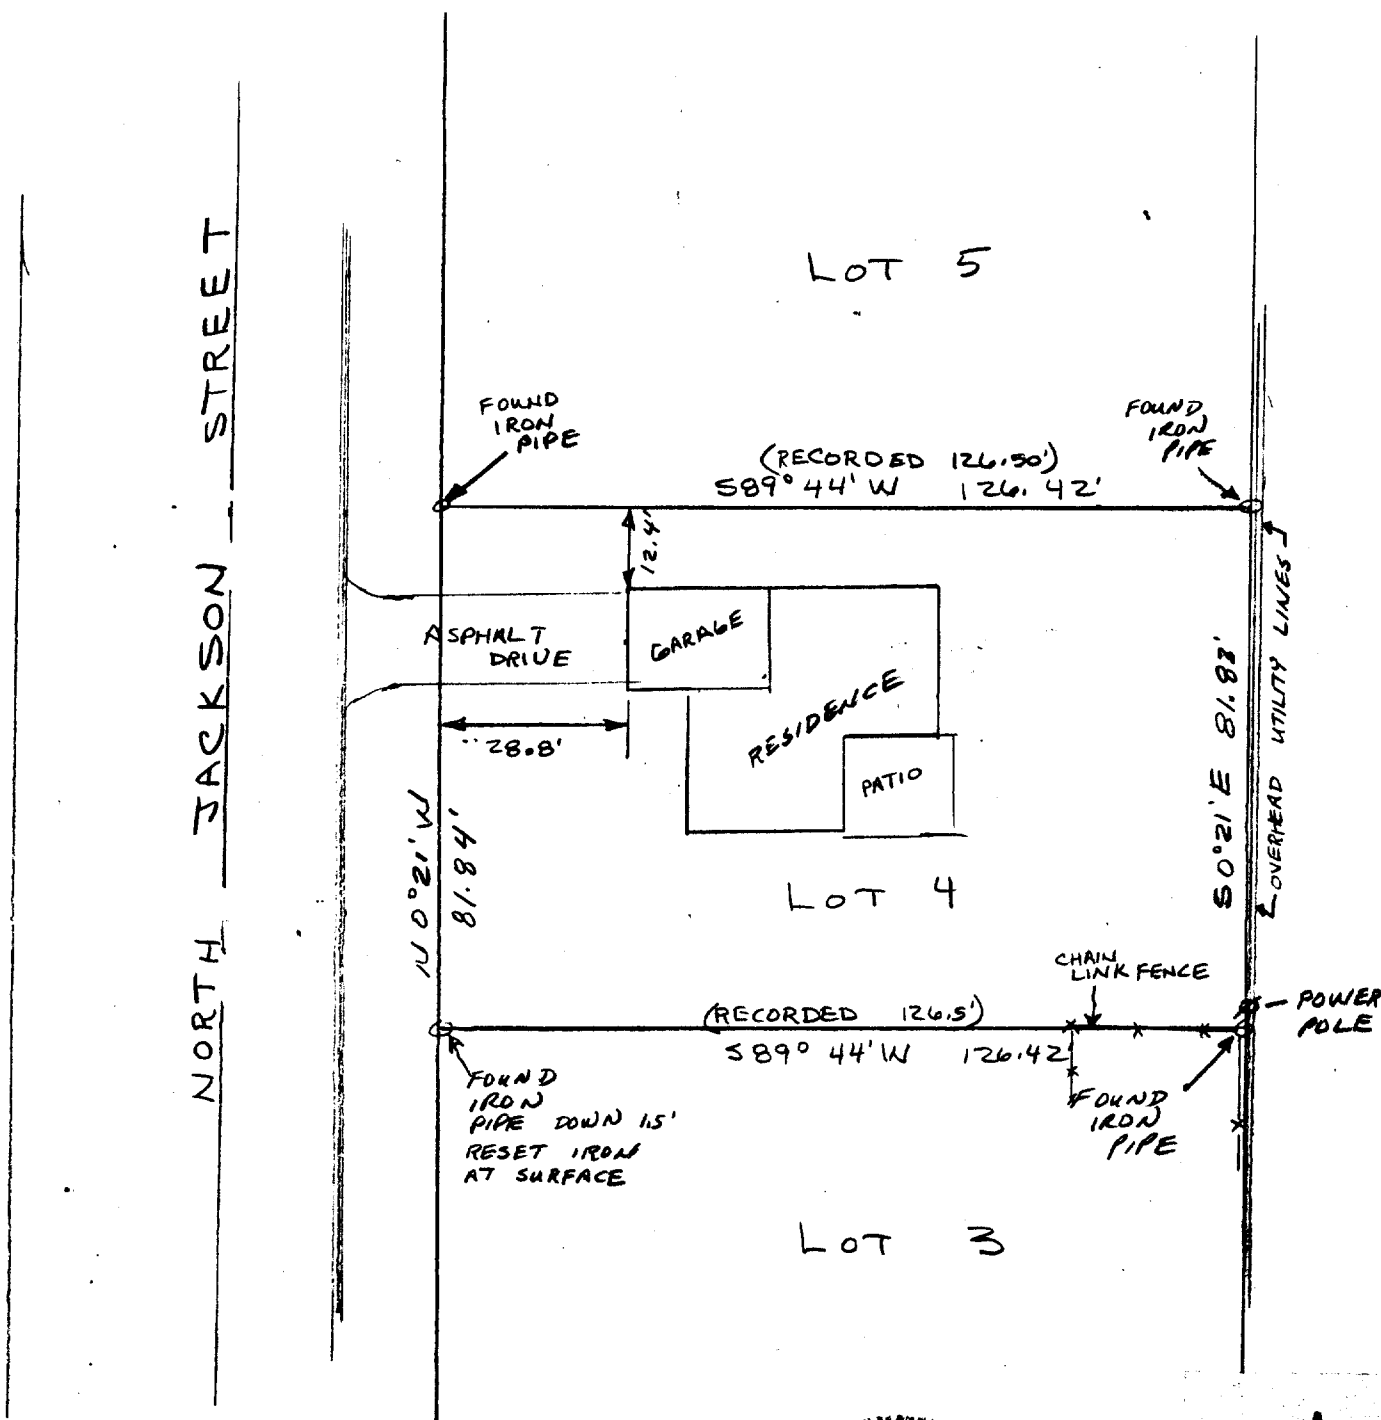


Plat of Survey of Lot 4, Block 2 of Tree Towns Subdivision being a subdivision located in the City of Elkhorn, Walworth County, Wis.

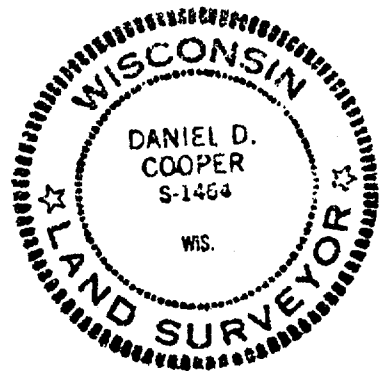

Survey ordered by Modern Realty- Elkhorn

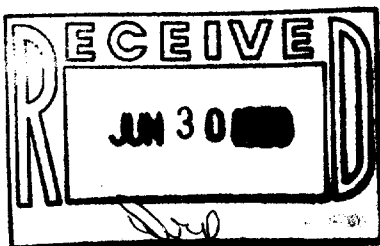

SCALE 1"=30'



I hereby certify that I have surveyed the property described hereon and that the map shown hereon is a true and accurate representation thereof to the best of my professional knowledge and belief.

Dated this 14 day of JUNE, 1988

YTT-116 *Daniel D Cooper*

4-824
 DRAWING NO. 3267