

PLAT OF SURVEY OF
LOT 14 OF BLOCK 2 OF FAIRLANE SUBDIVISION ADDITION NO. 1
IN THE CITY OF ELKHORN, WALWORTH COUNTY, WISCONSIN
FOR DAWN JORGENSEN


O = iron pipe stake found
● = iron rebar stake set
Bearings are relative to the
East line of Block 2 which
was assigned the bearing due
North as shown on orig. sub.

(xxx) - Original Plat Dimension

FARRIS, HANSEN & ASSOCIATES, INC.
Engineers Architects Surveyors
7 Ridgeway Court P.O. Box 497
ELKHORN, WISCONSIN 53121
Office: (414) 723-2098



NOTE: COPIES OF THIS MAP TO WHICH THE FOLLOWING
CERTIFICATE SHALL APPLY ARE BLUE LINE PRINTS WITH
THE SURVEYORS ORIGINAL SEAL AND SIGNATURE APPEARING
IN BLACK INK. COPIES BY ANY OTHER MEANS MAY
CONTAIN ALTERATIONS WHICH DO NOT REPRESENT THE
SURVEYOR'S WORK PRODUCT.

SANDY LANE

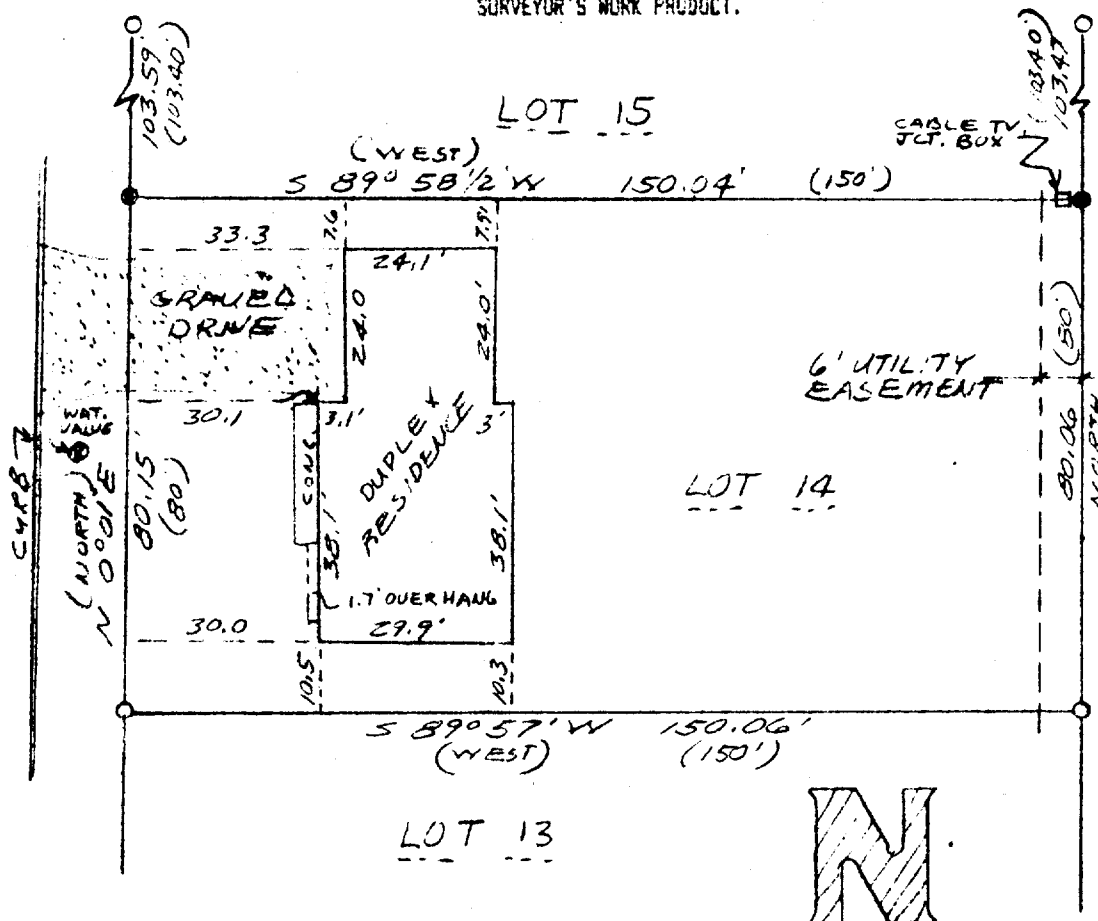

I hereby certify that I have surveyed the above
described property and that the above map is a true
representation thereof and shows the size and
location of the property, its exterior boundaries,
the location of all visible structures and
dimensions of all principal buildings thereon,
boundary fences, apparent easements, roadways and
visible encroachments, if any.
This survey is made for the use of the present
owners of the property, and also those who purchase,
mortgage, or guarantee the title thereto within one
(1) year from the date hereof.

DATED THIS 28TH DAY OF SEP, 1988

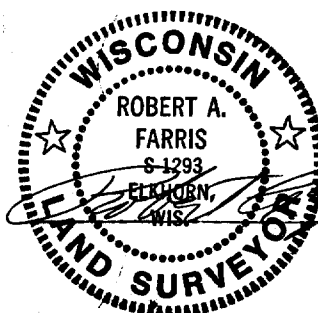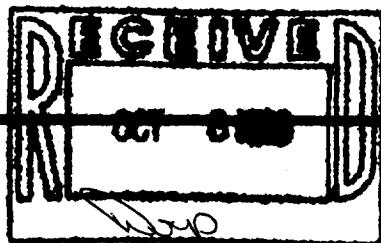

PROJ. 3109

4-529

DRAWING NUMBER 3109