


PLAT OF SURVEY of

Lot 39, Green Acres Subdivision located in Section 9,
18N, 11E, 31st of Elkhorn, Walworth County, Wisconsin

ORDERED BY: Ray Kehoe
1119 Meadowlark
Elkhorn, WI
723-5179

SURVEYED BY:
Jensen Surveying & Mapping S.C.
45 S. Wisconsin St. P.O. Box 322
Elkhorn, Wisconsin. 53121
(414) 723-3434

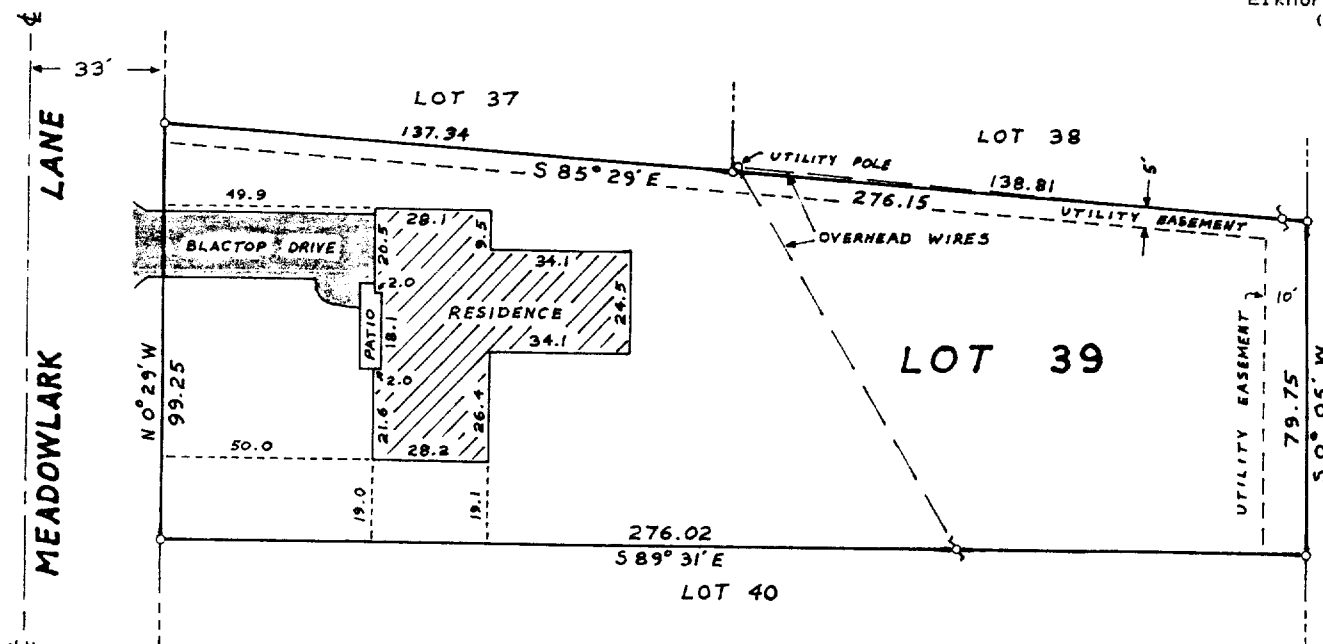

Bearings
referenced
to
Subdivision
Plat

SCALE:
1" = 30'

Mapping Date:
May 26, 1988

LEGEND

- Found Iron pipe
- ⊗ Utility Pole

Copyright © 1988 by Jensen Surveying & Mapping S.C.

All rights reserved. No part of this survey plat may be reproduced or transmitted in any form by any means - graphic, electronic, or mechanical, including photocopying, tracing, or information storage and retrieval systems - without permission in writing from Thomas P.A. Jensen, Jensen Surveying & Mapping S.C.

Note: This survey plat is not certified
unless signed and sealed in red ink.

I, Thomas P.A. Jensen, Wisconsin Registered Land Surveyor, do hereby certify that this survey was performed by me, or under my direction, in full compliance with the owner's/agent's instructions and Chapter A-E 5 of the Wisconsin Administrative Code "Minimum Standards For Property Surveys"; and that this map is an accurate representation thereof to the best of my knowledge and belief.

Thomas P.A. Jensen R.L.S.-1084
Jensen Surveying & Mapping S.C.

1988.05L