


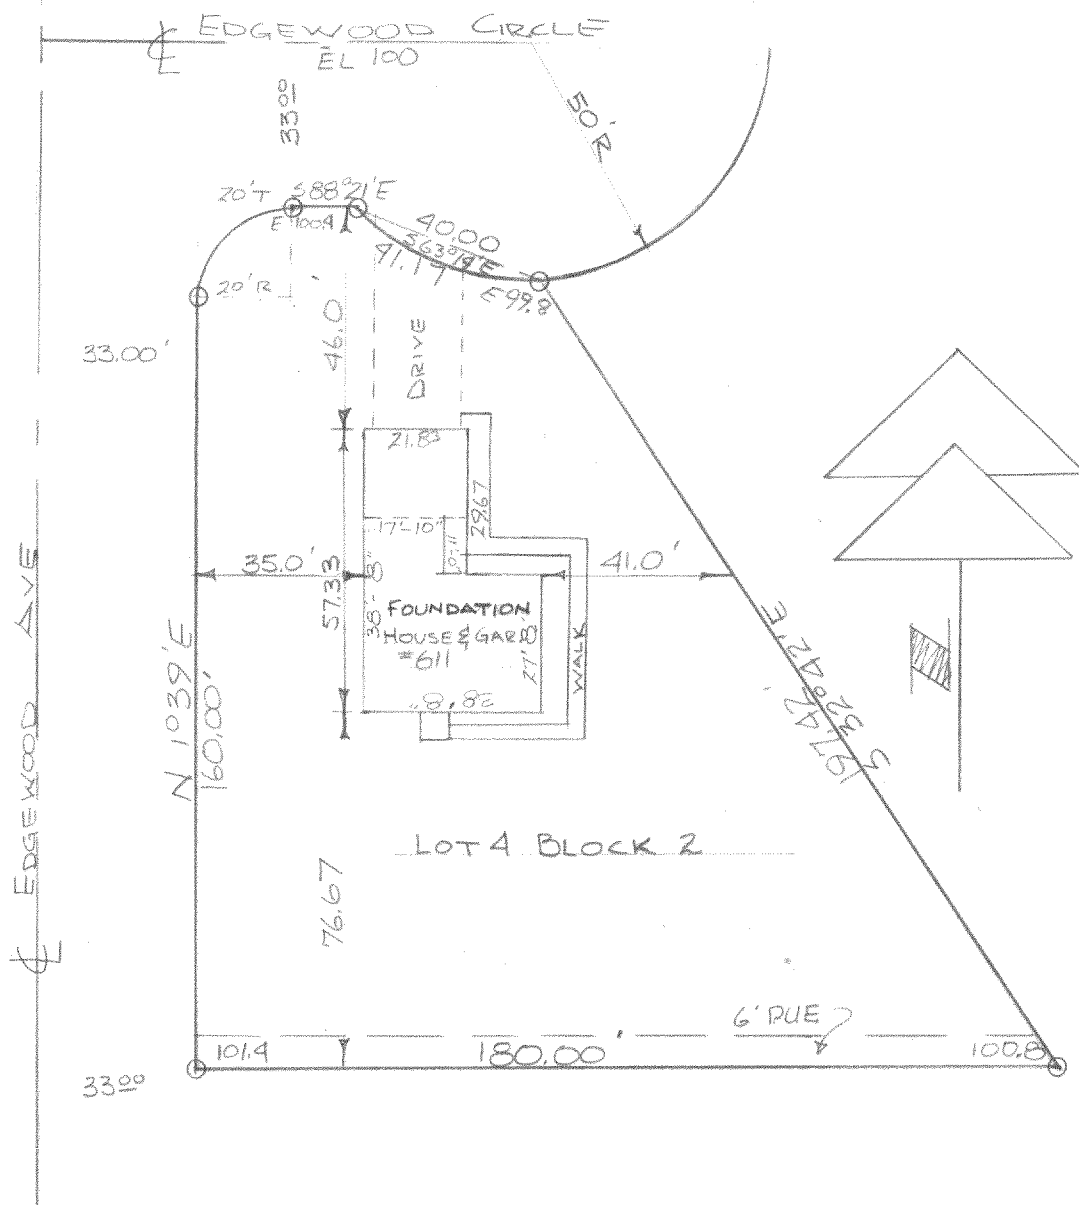

DESCRIPTION: Lot 4 of Block 2 of Edgewood first addition in the City of Elkhorn, Walworth County, Wisconsin.

CERTIFICATE: I, James F. Biagi, surveyor, do hereby certify that I have surveyed the property hereon described, and that the location of all the improvements are as shown on the drawing above.

October 11, 1961



James F. Biagi
James F. Biagi RLS 272

Recertified April 7, 1964

James F. Biagi
James F. Biagi RLS 272