


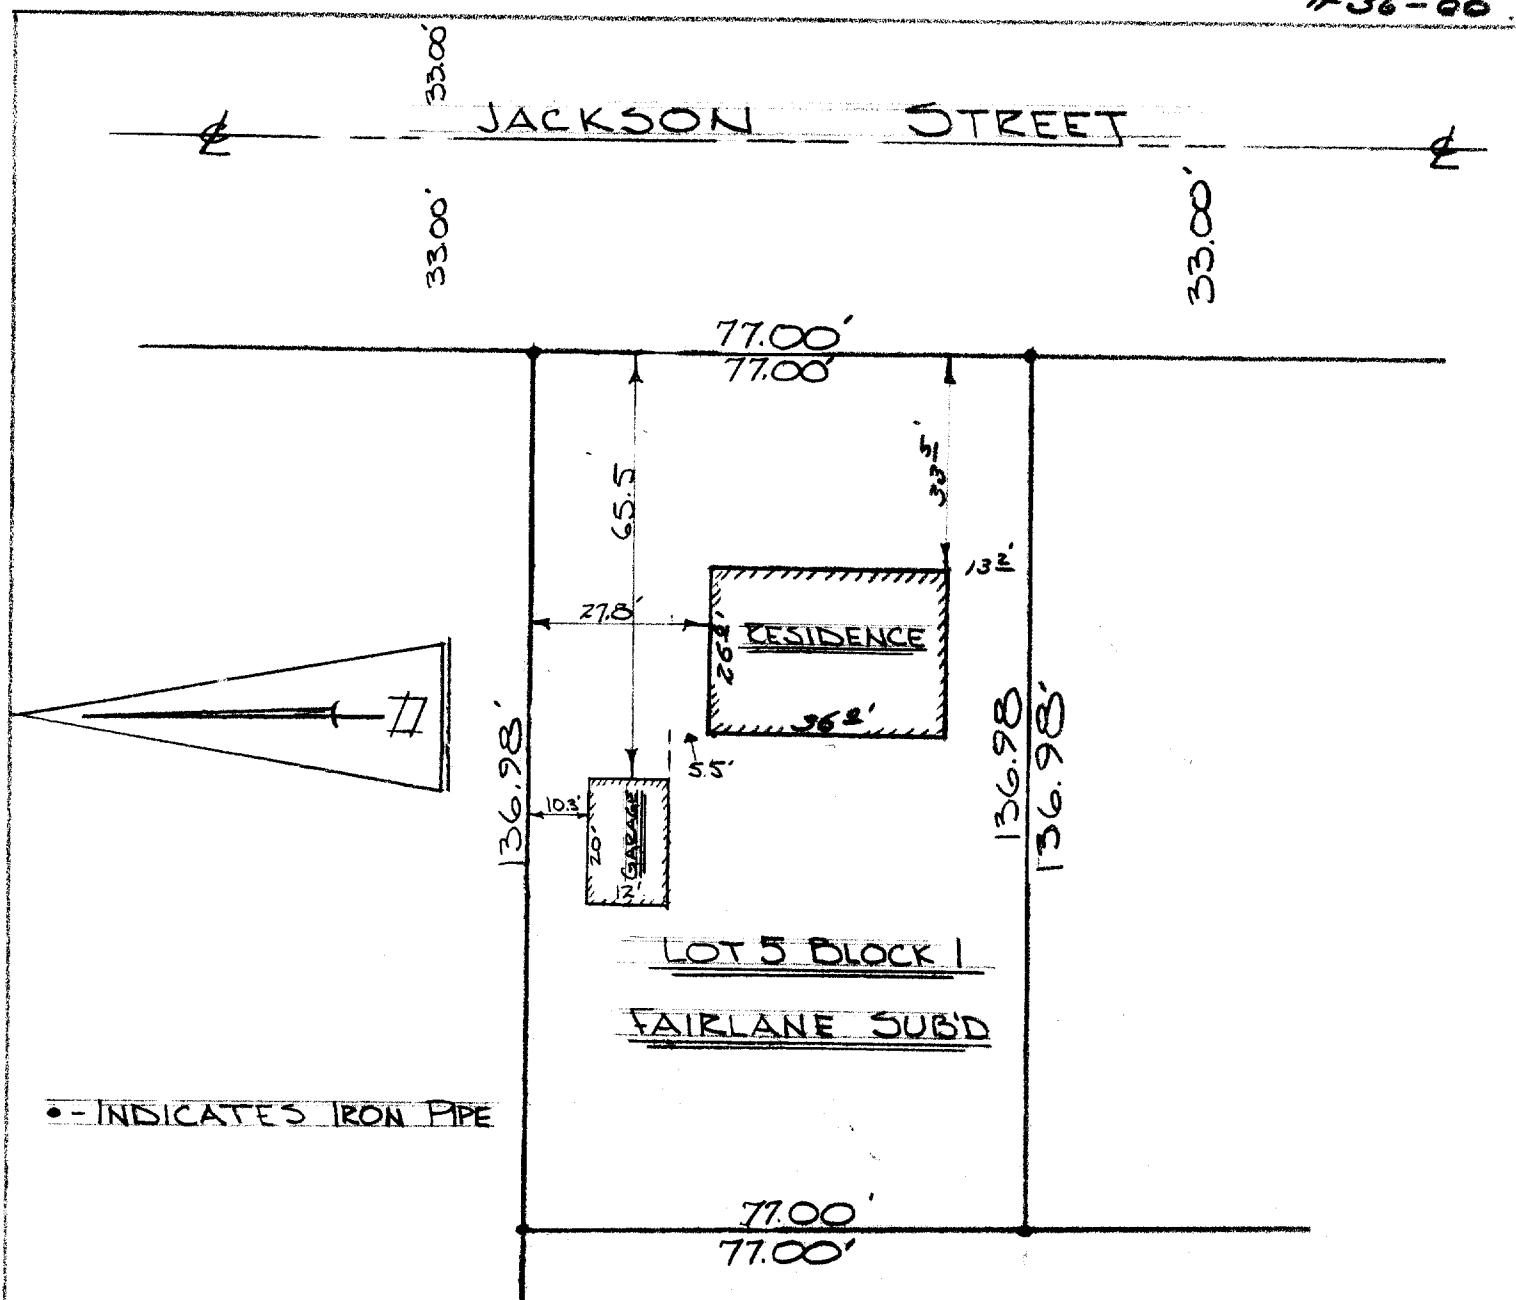


• - INDICATES IRON PIPE

DESCRIPTION: Lot 5, Block 1, Fairlane Subdivision, in the City of Elkhorn, Walworth County, Wisconsin.

Certificate: I, hereby certify that I have surveyed the above mentioned property and that the hereon portrayed is an accurate survey and a true representation thereof and correctly shows the exterior boundary lines and the location of the buildings and the other improvements thereof.

March 23, 1966.

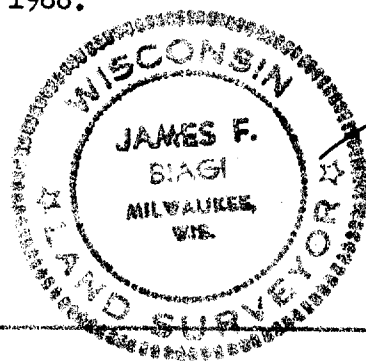

James F. Biagi RLS 272