


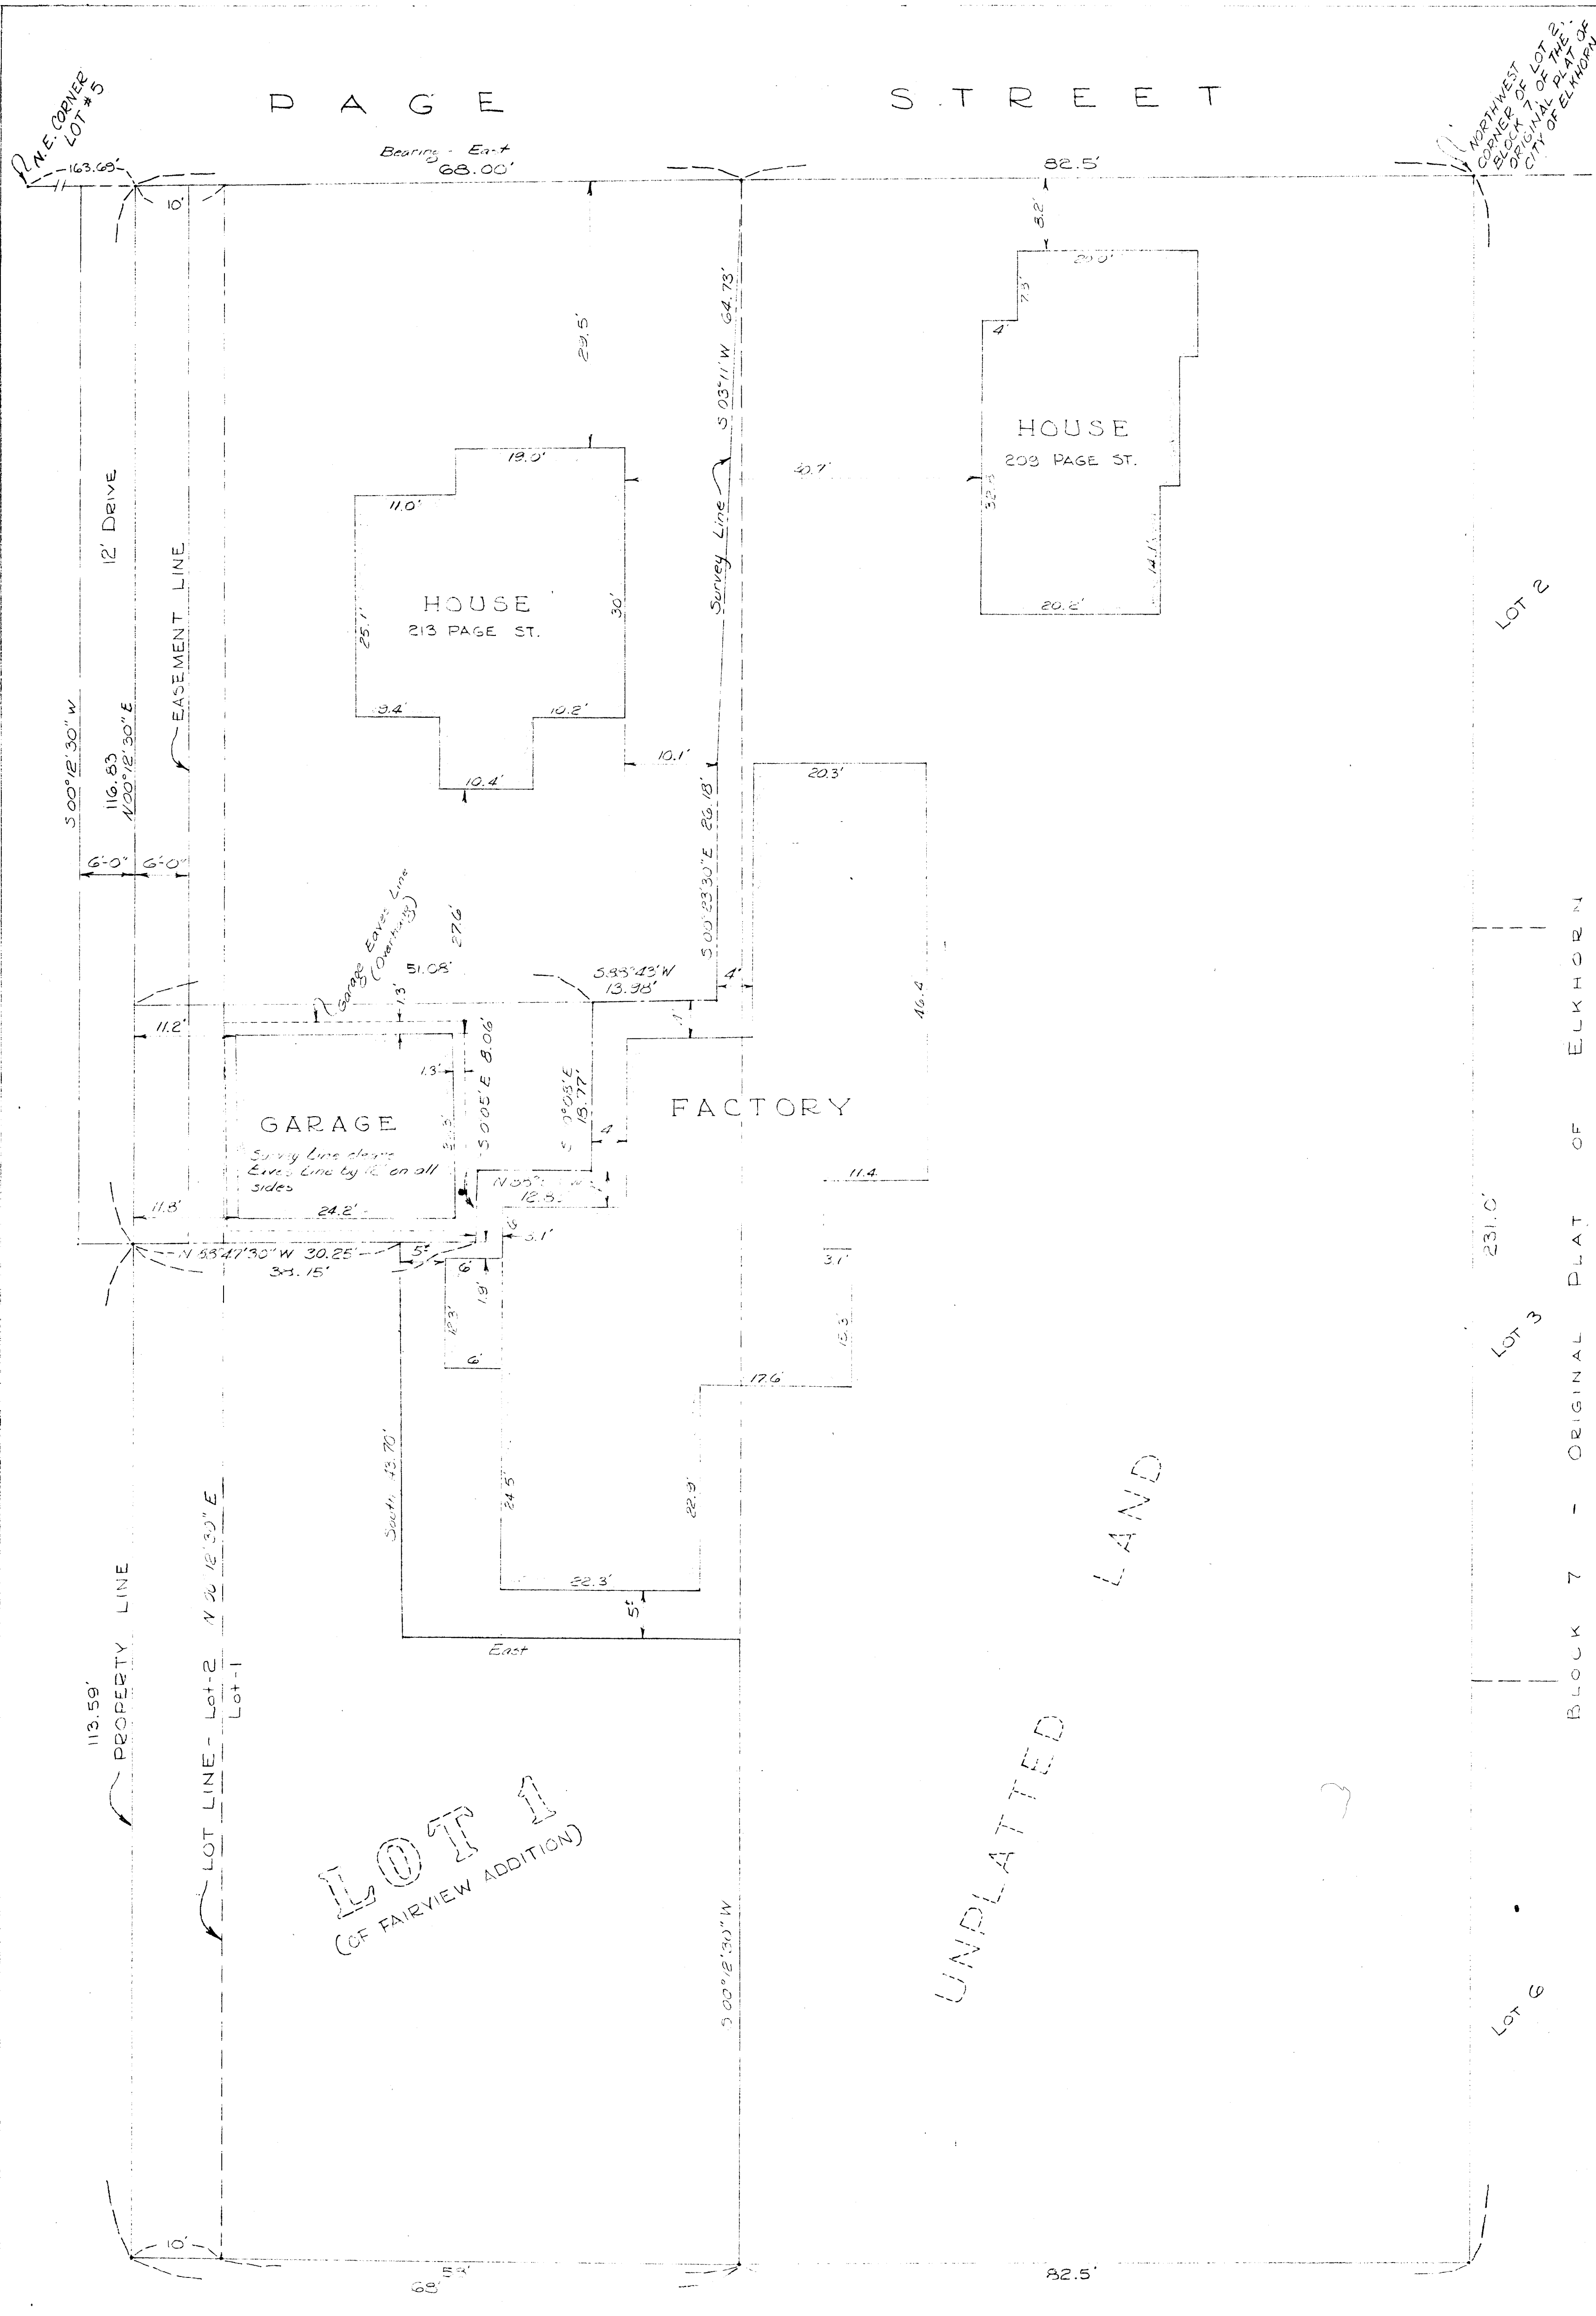

PAGE STREET

P.N.E. CORNER LOT #5

NORTHWEST CORNER OF LOT 2, BLOCK 7, ORIGINAL PLAT OF CITY OF ELKHORN

Bearing - East 68.00'

82.5'

12' DRIVE

EASEMENT LINE

Survey Line

HOUSE
203 PAGE ST.

HOUSE
213 PAGE ST.

FACTORY

GARAGE

Survey Line change
Eaves Line by 1/2" on all
sides

LOT 1
(OF FAIRVIEW ADDITION)

UNPLATTED


LAND

LOT 2

LOT 3

LOT 6

BLOCK 7 - ORIGINAL PLAT OF ELKHORN

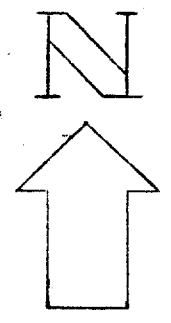

SCALE 1"=10'

PLAT OF SURVEY
OF LAND LOCATED IN THE CITY
OF ELKHORN, WISCONSIN

FEB. 4, 1963

H. L. Jensen
SURVEYOR

4-54

FR-1 and FR-1A

4-54