


4-55-72

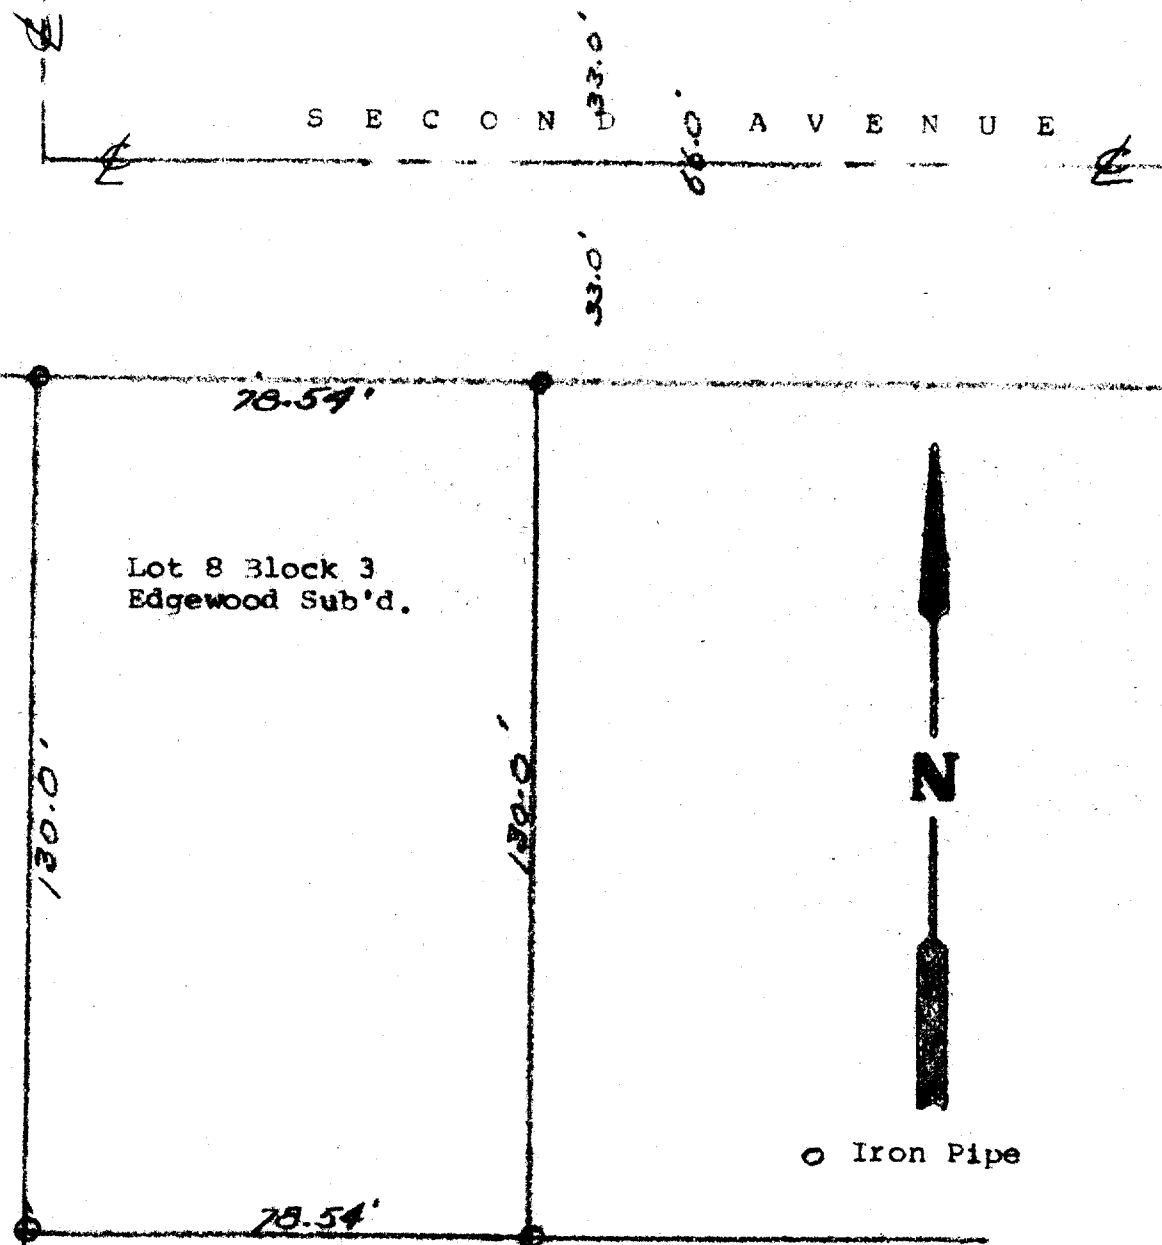

DESCRIPTION: Lot 8 Block 3 Edgewood Subdivision of a portion of the City of Elkhorn, Walworth County, Wisconsin.

CERTIFICATE: I, James F. Blasi surveyor do hereby certify that I have surveyed the property hereon described and portrayed.

Date: November 30th 1970.

James F. Blasi, NLS 272
Elkhorn, Wisconsin.

YE-14

4-55