

# PLAT OF SURVEY


- of -

Lot 7 of Edgewood Estates 1st Addition, located  
in the NW 1/4 of the NE 1/4 of Section 36,  
T3N, R16E, Walworth County, Wisconsin.

SURVEYED FOR

*G. LAST, ELKHORN*

Wisconsin, 53191

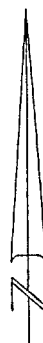

Bearing referenced to the  
subdivision plat.

SURVEYED BY: JENSEN SURVEYING & MAPPING S.C.  
45 S. Wisconsin Street P.O. Box 322  
Elkhorn, Wisconsin, 53121  
(414) 723-3434


Scale 1"=50'

## Legend

- Found iron pipe
- set iron pipe

BM#23 south bolt of  
hydrant of oak and  
edgewood  
BM#25 spike in power  
pole corner of  
C.T.H. "H" & edgewood

County Trunk Highway "H"

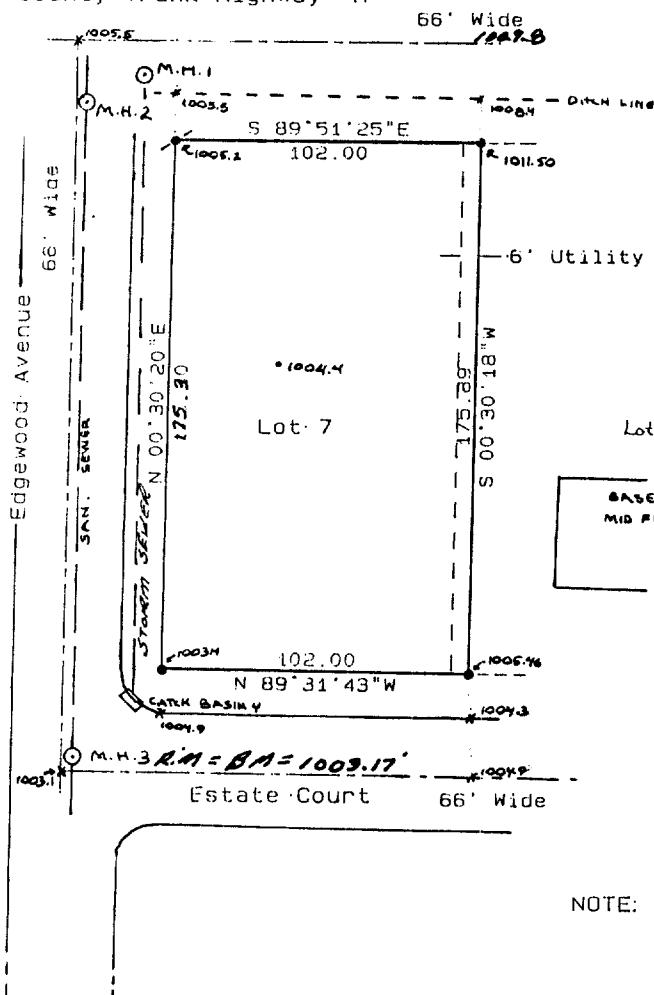


CATCH BASIN-elev.  
1002.67  
pipe going north  
invert elev. 997.75  
pipe going south  
invert elev. 997.87  
pipe going east  
invert elev. 998.37

BASEMENT ELEV. = 1002.67  
MID FLOOR ELEV. = 1001.98

M.H.1- elev. 1005.78  
pipe going west  
pipe going south  
invert elev. 996.54  
M.H.2- elev. 1004.77  
no pipes visible  
standing water-996.30  
invert elev.  
993.15  
M.H.3- elev. 1003.17  
no pipes visible  
standing water-996.37  
invert elev. 994.67

NOTE: This survey plat is not  
certified unless signed  
and sealed in red ink.

I, Thomas P.A. Jensen, Wisconsin Registered Land Surveyor,  
do hereby certify that this survey was performed by me, or under  
my direction, in full compliance with the owner's / agent's  
instructions and chapter A-E 5 of the Wisconsin Administrative  
Code "Minimum Standards For Property Surveys"; and that this map  
is an accurate representation thereof to the best of my knowledge  
and belief.

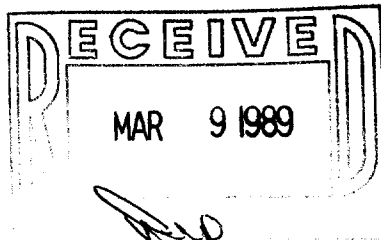

*Thomas P.A. Jensen*  
Thomas P.A. Jensen R.L.S. 1084  
9-17-86  
REVISED Oct. 28, 1988 1986.102 X  
4-552

